


STATE OF KANSAS
STATE CORPORATION COMMISSION

Give All Information Completely
Make Required Affidavit
Mail or Deliver Report to:
Conservation Division
State Corporation Commission
800 Biting Building
Wichita, Kansas

WELL PLUGGING RECORD

Seward County, Sec. 2 Twp. 31S Rge. (E) 32 (W)

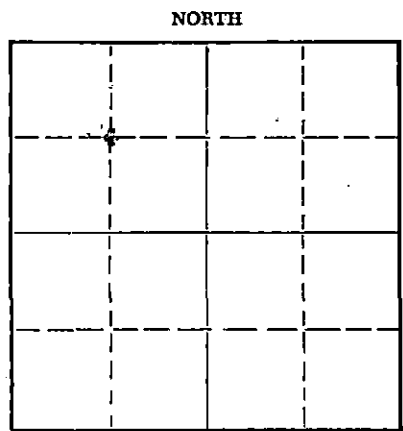

Locate well correctly on above Section Plat

Location as "NE/CNW/SW" or footage from lines C NW
Lease Owner Edwin L. Cox
Lease Name Fullmer Unit Well No. 1
Office Address 2100 Adolphus Tower, Dallas 2, Texas
Character of Well (completed as Oil, Gas or Dry Hole) Dry Hole
Date well completed Dry Hole 10-1-60 19
Application for plugging filed October 5, 19 60
Application for plugging approved (JL Brock) October 1, 19 60
Plugging commenced October 1, 19 60
Plugging completed October 1, 19 60
Reason for abandonment of well or producing formation Dry Hole

If a producing well is abandoned, date of last production _____ 19____
Was permission obtained from the Conservation Division or its agents before plugging was commenced? Yes

Name of Conservation Agent who supervised plugging of this well Mr. J.L. Brock and Mr. W.G. LaCamp
Producing formation None Depth to top _____ Bottom _____ Total Depth of Well 6560 Feet
Show depth and thickness of all water, oil and gas formations.

OIL, GAS OR WATER RECORDS

CASING RECORD

FORMATION	CONTENT	FROM	TO	SIZE	PUT IN	PULLED OUT
No OIL OR GAS SANDS				8-5/8"	1533	None

Describe in detail the manner in which the well was plugged, indicating where the mud fluid was placed and the method or methods used in introducing it into the hole. If cement or other plugs were used, state the character of same and depth placed, from _____ feet to _____ feet for each plug set.

Well was filled with mud-laden material; Cement was pumped through drill pipe and plugged at following depths: from 1525' to 1475' with 20 sacks; from 750' to 700' with 20 sacks; and from 35' to top with 20 sacks.

RECEIVED
STATE CORPORATION COMMISSION
OCT 12 1960
CONSERVATION DIVISION
Wichita, Kansas

(If additional description is necessary, use BACK of this sheet)
Name of Plugging Contractor Halliburton Oil Well Cementing Company
Address Liberal, Kansas

STATE OF Texas, COUNTY OF Dallas, ss.
Roy G. Walker (employee of owner) or (owner or operator) of the above-described well, being first duly sworn on oath, says: That I have knowledge of the facts, statements, and matters herein contained and the log of the above-described well as filed and that the same are true and correct. So help me God.

(Signature) Roy G Walker
2100 Adolphus Tower, Dallas 2, Texas
(Address)

SUBSCRIBED AND SWORN TO before me this 6th day of October, 19 60

My commission expires 6-1-61
Gertrude Cotten
Notary Public.

