


STATE OF KANSAS  
STATE CORPORATION COMMISSION

WELL PLUGGING RECORD

Give All Information Completely  
Make Required Affidavit  
Mail or Deliver Report to  
Conservation Division  
State Corporation Comm.  
245 North Water  
Wichita, KS 67202

Seward County, Sec. 9 Twp. 34S Rge. 32 N/W  
Location as "NE/CNW $\frac{1}{4}$ SW $\frac{1}{4}$ " or footage from lines  
C NW SE  
Lease Owner Tucker Production  
Lease Name Pittman Well No. 1-9  
Office Address 2546 W. Main, Littleton, Colo. 80120  
Character of Well (Completed as Oil, Gas or Dry Hole)  
Dry Hole  
Date Well completed August 10 1982  
Application for plugging filed August 10 1982  
Application for plugging approved -- 19  
Plugging commenced August 9 1982  
Plugging completed August 10 1982  
Reason for abandonment of well or producing formation  
Non-Commercial  
If a producing well is abandoned, date of last production  
None 19

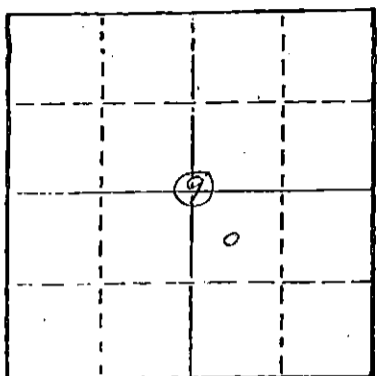

Locate well correctly on above  
Section Plat

Name of Conservation Agent who supervised plugging of this well Steve Durant  
Producing formation --- Depth to top --- Bottom --- Total Depth of Well 16490'  
Show depth and thickness of all water, oil and gas formations.

OIL, GAS OR WATER RECORDS

CASING RECORD

FORMATION	CONTENT	FROM	TO	SIZE	PUT IN	PULLED OUT
				8-5/8"	1534	None
				---	None	---

Describe in detail the manner in which the well was plugged, indicating where the mud fluid was placed and the method or methods used in introducing it into the hold. If cement or other plugs were used, state the character of same and depth placed, from feet to feet for each plug set.

- 60 sx 50/50 Pozmix w/ 4% gel and 3% CaCl @ 1500'
- 60 sx 50/50 Pozmix w/ 4% gel and 3% CaCl @ 600'
- 10 sx 50/50 Pozmix w/ 4% gel and 3% CaCl @ 40'
- 10 sx 50/50 Pozmix w/ 4% gel and 3% CaCl in rat hole
- 5 sx 50/50 Pozmix w/ 4% gel and 3% CaCl in mouse hole

Complete 1:18 a.m., 8/10/82

(If additional description is necessary, use BACK of this sheet)

Name of Plugging Contractor Halliburton Services

STATE OF Kansas COUNTY OF Seward, ss.  
R.L. Higginbottom, agent (employee of owner) or (owner or operator)  
of the above-described well, being first duly sworn on oath, says: That I have knowledge of the facts, statements, and matters herein contained and the log of the above-described well as filed and that the same are true and correct. So help me God.

(Signature) *R.L. Higginbottom*  
P.O. Box 6; Liberal, KS 67901  
(Address)

SUBSCRIBED AND SWORN TO before me this 10th day of August, 19 82

My commission expires  
NOTARY PUBLIC - State of Kansas  
A. J. PARNELL  
My Appt. Exp. 7-7-85

*A. J. Parnell*  
Notary Public.

RECEIVED  
STATE CORPORATION COMMISSION

AUG 11 1982

CONSERVATION DIVISION  
Wichita, Kansas

DRILLER'S LOG

Tucker Production Corporation  
2546 West Main  
Littleton, CO 80120

Pittman #1-9  
C NW SE  
Section 9-34S-32W  
Seward County, Kansas

Commenced: 7/26/82  
Completed: 8/10/82

RTD: 6490'

Surface Casing: Drilled 12-1/4" hole to 1535'; ran 37 jts., 8-5/8" 23# (new) LS casing; tally 1542.97', set casing @ 1534'; Howco cement w/ 550 sx HLC, 1/4# /sx flocele, 2% CaCl<sub>2</sub> plus 150 sx Class H, 2% CaCl<sub>2</sub>. Plug down @ 9:45 a.m. 7/27/82. Cement circulated, WOC 12 hrs.


0'	to	689'	Water sand & Red Bed
689'	to	1405'	Red Bed, gyp, sand
1405'	to	2365'	Red bed, anhydrite
2365'	to	6490'	TD. Lime, Shale.

I certify that this is a true and correct copy of the log on the above captioned well to the best of my knowledge.

J. B. BOHANNAN DRILLING, INC.

By *R. L. Higginbottom*  
R. L. Higginbottom, President

Subscribed and sworn to before me this 10th day of August, 1982.

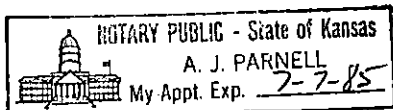

My Commission Expires 7-7-85

*A. J. Parnell*  
A. J. Parnell, Notary

RECEIVED  
STATE CORPORATION COMMISSION

AUG 11 1982

CONSERVATION DIVISION  
Wichita, Kansas