


STATE OF KANSAS
STATE CORPORATION COMMISSION

WELL PLUGGING RECORD

Give All Information Completely
Make Required Affidavit
Mail or Deliver Report to
Conservation Division
State Corporation Comm.
245 North Water
Wichita, KS 67202

Seward County, Sec. 20 Twp. 34S Rge. 32 E/W
Location as "NE/CNW $\frac{1}{2}$ SW $\frac{1}{2}$ " or footage from lines
SE SE SW

Lease Owner Irex Corporation
Lease Name Nichols Well No. #1
Office Address 1670 Broadway - Suite 3301, Denver, Co. 80202
Character of Well (Completed as Oil, Gas or Dry Hole)

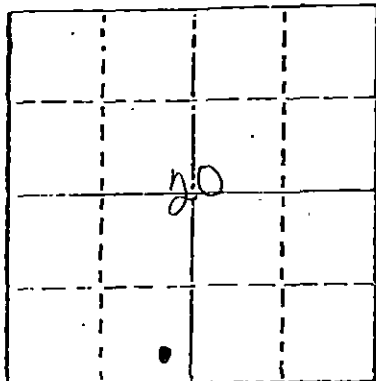

Locate well correctly on above Section Plat

Dry Hole
Date Well completed 5-1-82 19
Application for plugging filed 5-1-82 19
Application for plugging approved 5-1-82 19
Plugging commenced 5-1-82 19
Plugging completed 5-1-82 19

Reason for abandonment of well or producing formation
Commercial quantities of oil not found
If a producing well is abandoned, date of last production 19.

Was permission obtained from the Conservation Division or its agents before plugging was commenced? Yes

Name of Conservation Agent who supervised plugging of this well Paul Luthi
Producing formation Depth to top Bottom Total Depth of Well 6600'
Show depth and thickness of all water, oil and gas formations.

OIL, GAS OR WATER RECORDS

CASING RECORD

FORMATION	CONTENT	FROM	TO	SIZE	PUT IN	PULLED OUT
				8 5/8"	1556'	None

Describe in detail the manner in which the well was plugged, indicating where the mud fluid was placed and the method or methods used in introducing it into the hold. If cement or other plugs were used, state the character of same and depth placed, from feet to feet for each plug set.

- Plug @ 1580' w/60 sx.
- Plug @ 780' w/35 sx.
- Plug @ 40' w/10 sx.
- Rat Hole 5 sx.
- Mouse Hole 5 sx.

(If additional description is necessary, use BACK of this sheet)

Name of Plugging Contractor Rains & Williamson Oil Co., Inc.

STATE OF Kansas COUNTY OF Sedgwick, ss.
Wilson Rains, President of Rains & Williamson Oil Co. (employee of owner) or (owner or operator) of the above-described well, being first duly sworn on oath, says: That I have knowledge of the facts, statements, and matters herein contained and the log of the above-described well as filed and that the same are true and correct. So help me God.

(Signature) Wilson Rains
435 Page Court, 220 W. Douglas, Wichita, Ks. 67202
(Address)

SUBSCRIBED AND SWORN TO before me this 4 day of May, 19 82

Juanita M. Green
Juanita M. Green Notary Public.

My commission expires 10-4-83



RECEIVED
STATE CORPORATION COMMISSION
MAY 27 1982
5-27-82
CONSERVATION DIVISION
Wichita Kansas

DRILLER'S LOG

COMPANY: Irex Corporation

SEC. 20 T. 34S R. 32W

LOC. SE SE SW

WELL NAME: Nichols #1

COUNTY: Seward

RIG NO. #5

TOTAL DEPTH 6600'

ELEVATION

COMMENCED: 4-13-82

COMPLETED: 5-1-82

CONTRACTOR: Rains & Williamson Oil Co., Inc.

RECEIVED

MAY 6 1982

IREX Corp.

CASING RECORD:

SURFACE: 8 5/8" @ 1556' w/900 sx. 50/50 poz., 3% gel, 2% cc., 1/4# seeloseal and 200 sx. Class H, 2% cc.

PRODUCTION: D&A

LOG

(Figures Indicate Bottom of Formations)

Sand	561
Sand & Clay	1515
Redbed	1557
Shale & Redbed	2191
Shale	2415
Lime & Shale	6600
<u>ROTARY TOTAL DEPTH</u>	<u>6600</u>

RECEIVED
STATE CORPORATION COMMISSION

MAY 27 1982

CONSERVATION DIVISION
Wichita, Kansas

STATE OF Kansas)

COUNTY OF Sedgwick)

SS:

I, Wilson Rains, President of Rains & Williamson Oil Co., Inc.

upon oath state that the above and foregoing is a true and correct copy of the log of the
Nichols #1 well.

Wilson Rains
Wilson Rains

Subscribed and sworn to before me this 4 day of May, 1982.

My Appointment Expires:

10-4-83

Juanita M. Green
Juanita M. Green

