

DRILLER'S LOG

WELL NAME: Condit "B" No. 1 ; COMPANY OPERATING: Anadarko Production Company
 ADDRESS of COMPANY: Box 351, Liberal, Kansas

WELL LOCATION: C 1/4 SW 1/4 NW 1/4,
3300 ft. North of South line,
4455 ft. East of West line; Sec. 18, Twp. 34, Rge. 32W, Seward County, Kansas

DRILLING STARTED August 2, 1965; DRILLING COMPLETED August 15, 1965
 WELL COMPLETED August 15, 1965; WELL CONNECTED _____, 19____

ELEVATION: 2810.63 ft. Ground Level; CHARACTER OF WELL (Oil, Gas, or Dry Hole) Dry Hole

OIL OR GAS SANDS OR ZONES - PERFORATIONS - ACIDIZING AND FRACTURING INFORMATION					
Name	From	To	No. of Shots	Gallons Used	Kind Used

CASING RECORD

Size	Amount Set	Sacks of Cement	Amount Pulled
8-5/8	1599'	700	None

FORMATION RECORD

Formation	Top	Bottom	Formation	Top	Bottom
Surface Sand	0	2355			
Anhy. & Shale	2355	2906			
Lime & Shale	2906	3120			
Chalky Lime	3120	3720			
Lime & Shale	3720	4477			
Lime	4477	5455			
Lime & Shale	5455	5590			
Shale & Lime	5590	6232			
Shale & Sand Lime	6232	6380			
Total Depth		6380			

RECEIVED
 STATE CORPORATION COMMISSION

AUG 10 1965

CONSERVATION DIVISION
 Wichita, Kansas

RESULTS of INITIAL PRODUCTION TEST: _____

Give All Information Completely
Make Required Affidavit
Mail or Deliver Report to:
Conservation Division
State Corporation Commission
211 No. Broadway
Wichita, Kansas

WELL PLUGGING RECORD

Location as "NE/CNW/SW" or footage from lines Seward County, Sec. 18 Twp. 34 Rge. 326 (E) 32 (W)

Lease Owner Anadarko Production Company

Lease Name Condit "B" Well No. 1

Office Address Box 351, Liberal, Kansas

Character of Well (completed as Oil, Gas or Dry Hole) Dry Hole

Date well completed August 15 19 65

Application for plugging filed August 16 19 65

Application for plugging approved August 16 19 65


Plugging commenced August 16 19 65

Plugging completed August 16 19 65

Reason for abandonment of well or producing formation Dry Hole

If a producing well is abandoned, date of last production 19

Was permission obtained from the Conservation Division or its agents before plugging was commenced? Yes - Orally by State Pluggger

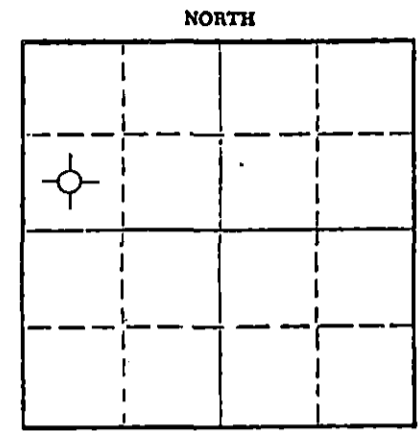

Locate well correctly on above Section Plat

Name of Conservation Agent who supervised plugging of this well Eldon Petty

Producing formation None Depth to top -- Bottom -- Total Depth of Well 6380 Feet

Show depth and thickness of all water, oil and gas formations.

OIL, GAS OR WATER RECORDS				CASING RECORD		
FORMATION	CONTENT	FROM	TO	SIZE	PUT IN	PULLED OUT
				8-5/8	1599	None

Describe in detail the manner in which the well was plugged, indicating where the mud fluid was placed and the method or methods used in introducing it into the hole. If cement or other plugs were used, state the character of same and depth placed, from _____ feet to _____ feet for each plug set.
Filled hole with mud to 700', formed bridge, spotted 35 sacks common cement at 700'. Filled hole with mud to 45', formed bridge, spotted 15 sacks from 45' to 4' below ground level. Completed at 3:00 p.m. August 16, 1965.

RECEIVED
STATE CORPORATION COMMISSION

AUG 19 1965

CONSERVATION DIVISION
Wichita, Kansas

(If additional description is necessary, use BACK of this sheet)

Name of Plugging Contractor Moran Bros.

Address _____

STATE OF Kansas COUNTY OF Seward ss.

W. L. Downey (employee of owner) or (owner or operator) of the above-described well, being first duly sworn on oath, says: That I have knowledge of the facts, statements, and matters herein contained and the log of the above-described well as filed and that the same are true and correct. So help me God.

(Signature) W. L. Downey

(Address)

SUBSCRIBED AND SWORN TO before me this 18th day of August, 1965.

Donald L. Carpenter
Notary Public.

My commission expires _____
My Commission Expires Sept. 29, 1968