


STATE OF KANSAS  
STATE CORPORATION COMMISSION

WELL PLUGGING RECORD

Give All Information Completely  
Make Required Affidavit  
Mail or Deliver Report to  
Conservation Division  
State Corporation Comm.  
245 North Water  
Wichita, KS 67202  
R 32 W

Seward County. Sec. 18 Twp. 34 Rge. 32W E/W  
Location as "NE/CNW $\frac{1}{4}$ SW $\frac{1}{4}$ " or footage from lines  
C E/2 E/2

Lease Owner Beren Corporation  
Lease Name Dodd Well No. 2-18  
Office Address 401 East Douglas; Wichita, Kansas 67202  
Character of Well (Completed as Oil, Gas or Dry Hole)

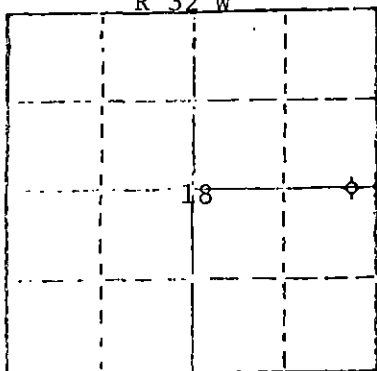

Locate well correctly on above Section Plat

Dry hole  
Date Well completed May 5, 1984  
Application for plugging filed 5-5-1984  
Application for plugging approved 1984  
Plugging commenced 5-5-1984  
Plugging completed 5-5-1984

Reason for abandonment of well or producing formation  
Dry hole

If a producing well is abandoned, date of last production  
(CL) 19

Was permission obtained from the Conservation Division or its agents before plugging was commenced? yes

Name of Conservation Agent who supervised plugging of this well 1-800-362-1358  
Producing formation \_\_\_\_\_ Depth to top \_\_\_\_\_ Bottom \_\_\_\_\_ Total Depth of Well 6090  
Show depth and thickness of all water, oil and gas formations.

OIL, GAS OR WATER RECORDS

CASING RECORD

FORMATION	CONTENT	FROM	TO	SIZE	PUT IN	PULLED OUT

Describe in detail the manner in which the well was plugged, indicating where the mud fluid was placed and the method or methods used in introducing it into the hold. If cement or other plugs were used, state the character of same and depth placed, from \_\_\_\_\_ feet to \_\_\_\_\_ feet for each plug set.

Plugged to abandon Set #1 Plug @ 2500' w/50 sacks. #2 Plug @ 1620' w/ 40 sacks.  
#3 Plug @ 810' w/40 sacks. #4 Plug @ 40' w/10 sacks. Plug Rat Hole w/15 sacks. Mouse Hole w/10 sacks. All cement is 60/40 Poz Mix.

(If additional description is necessary, use BACK of this sheet)

Name of Plugging Contractor Halliburton Hugoton, Ks.

STATE OF OKLAHOMA COUNTY OF OKLAHOMA, ss.  
(employee of owner) or (owner or operator)

of the above-described well, being first duly sworn on oath, says: That I have knowledge of the facts, statements, and matters herein contained and the log of the above-described well as filed and that the same are true and correct. So help me God.

(Signature) Pete Wilson PETE WILSON  
5101 N. Classen Blvd., Ste 205, OKC, OK 73118  
(Address)

SUBSCRIBED AND SWORN TO before me this 21st day of May, 19

My commission expires July 12, 1986

Linda L. Stewart  
LINDA L. STEWART Notary Public.

RECEIVED  
STATE CORPORATION COMMISSION

MAY 25 1984

CONSERVATION DIVISION  
Wichita, Kansas