


STATE OF KANSAS  
STATE CORPORATION COMMISSION

Form CP-4

Give All Information Completely  
Make Required Affidavit  
Mail or Deliver Report to:  
Conservation Division  
State Corporation Commission  
212 No. Market  
Wichita, Kansas

## WELL PLUGGING RECORD

NORTH

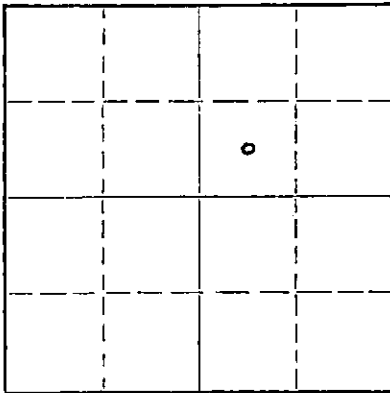

Locate well correctly on above  
Section Plat

Seward County. Sec. 15 Twp. 34 Rge. 32 (E) (W)  
Location as "NE/CNW/SW" or footage from lines C SW NE  
Lease Owner PAR Petroleum, Inc.  
Lease Name Hawkyard Well No. 1  
Office Address P.O. Box 280, Liberal, Kansas 67901  
Character of Well (completed as Oil, Gas or Dry Hole) Dry Hole  
Date well completed - - 19 -  
Application for plugging filed 7-20 1977  
Application for plugging approved 7-20 1977  
Plugging commenced 7-20 1977  
Plugging completed 7-20 1977  
Reason for abandonment of well or producing formation Dry Hole

If a producing well is abandoned, date of last production - - 19 -  
Was permission obtained from the Conservation Division or its agents before plugging was commenced? yes

Name of Conservation Agent who supervised plugging of this well Clarence Thomas  
Producing formation - - Depth to top - - Bottom - - Total Depth of Well 6457 Feet  
Show depth and thickness of all water, oil and gas formations.

## OIL, GAS OR WATER RECORDS

## CASING RECORD

FORMATION	CONTENT	FROM	TO	SIZE	PUT IN	PULLED OUT
Sand		0	568			
Red Bed		568	1035			
Glorietta		1035	1161			
Red Bed - Anhy.		1161	1570			
Anhy. - Shale - Lime		1570	1780			
Red Bed - Anhy. - Shale		1780	2329			
Anhy. - Shale		2329	2559			
Shale - Lime		2559	2736			

Describe in detail the manner in which the well was plugged, indicating where the mud fluid was placed and the method or methods used in introducing it into the hole. If cement or other plugs were used, state the character of same and depth placed, from feet to feet for each plug set.

Dolo.	2736	3007
Dolo. - Lime - Shale	3007	3239
Lime - Shale	3239	6457

30 Sacks cement from bottom of surface pipe, 1577' to 1500',  
10 sacks from 40' back to surface. Surface pipe cut off 3 feet below ground level.  
5 sacks cement put in Mouse Hole.  
5 sacks cement put in Rat Hole.

RECEIVED  
STATE CORPORATION COMMISSION

AUG 30 1977

CONSERVATION DIVISION  
Wichita, Kansas

(If additional description is necessary, use BACK of this sheet)

Name of Plugging Contractor Unit Drilling Co.  
Address Tulsa, Oklahoma

STATE OF Kansas, COUNTY OF Seward, ss.

(employee of owner) or (owner or operator) of the above-described well, being first duly sworn on oath, says: That I have knowledge of the facts, statements, and matters herein contained and the log of the above-described well as filed and that the same are true and correct. So help me God.

(Signature)

Box 280, Liberal, Kansas 67901

(Address)

SUBSCRIBED AND SWORN to before me this 29 day of August, 1977

My commission expires

Notary Public.