


STATE OF KANSAS  
STATE CORPORATION COMMISSION

WELL PLUGGING RECORD

Give All Information Completely  
Make Required Affidavit  
Mail or Deliver Report to:  
Conservation Division  
State Corporation Commission  
211 No. Broadway  
Wichita, Kansas

Sumner County, Sec. 6 Twp. 34S Rge. (E) 3 (W)

Location as "NE/CNW/SW" or footage from lines SE SW SE  
Lease Owner Dorset Co.  
Lease Name Bulta Heirs Well No. 1  
Office Address 610 National Bank of Tulsa Bldg., Tulsa, Oklahoma  
Character of Well (completed as Oil, Gas or Dry Hole) dry hole  
Date well completed 8-4-61 19  
Application for plugging filed 8-4-61 19  
Application for plugging approved 8-4-61 19  
Plugging commenced 8-4-61 19  
Plugging completed 8-4-61 19  
Reason for abandonment of well or producing formation dry hole

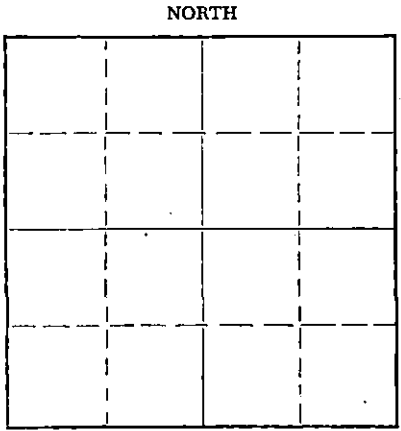

Locate well correctly on above  
Section Plat

If a producing well is abandoned, date of last production 19  
Was permission obtained from the Conservation Division or its agents before plugging was commenced? yes

Name of Conservation Agent who supervised plugging of this well Fred Hampel  
Producing formation \_\_\_\_\_ Depth to top \_\_\_\_\_ Bottom \_\_\_\_\_ Total Depth of Well \_\_\_\_\_ Feet  
Show depth and thickness of all water, oil and gas formations.

OIL, GAS OR WATER RECORDS

CASING RECORD

FORMATION	CONTENT	FROM	TO	SIZE	PUT IN	PULLED OUT

Describe in detail the manner in which the well was plugged, indicating where the mud fluid was placed and the method or methods used in introducing it into the hole. If cement or other plugs were used, state the character of same and depth placed, from \_\_\_\_\_ feet to \_\_\_\_\_ feet for each plug set.

Mud 1730 - 240  
Cement 240 - 195  
Mud 195 - 35  
Cement 35 - Surface

RECEIVED  
STATE CORPORATION COMMISSION

AUG 10 1961

CONSERVATION DIVISION  
Wichita, Kansas

(If additional description is necessary, use BACK of this sheet)

Name of Plugging Contractor V. W. McKnab  
Address Box 808, Winfield, Kansas

STATE OF Kansas, COUNTY OF Cowley, ss.  
Melvin Liebau (employee of owner) or (owner) of the above-described well, being first duly sworn on oath, says: That I have knowledge of the facts, statements, and matters herein contained and the log of the above-described well as filed and that the same are true and correct. So help me God.

(Signature) Melvin Liebau  
Box 808, Winfield, Kansas (Address)

SUBSCRIBED AND SWORN TO before me this 9th day of August, 19 61

My commission expires July 31, 1965  
Roberts May Notary Public.



15-191-00151-0000

WELL RECORD  
Bulta Heirs #1  
SE SW SE Sec. 6-348-3W  
Summer County, Kansas

Operator: Dorset Company  
Contractor: V. W. McKnab

Date Comm: 7-16-61  
Date Under Surf: 7-17-61  
Date Comp: 8-4-61

DRILLER'S LOG:

0 - 100	Shale
100 - 215	Shale & Shells
215 - 286	Lime & Shale
286 - 655	Shale & Shells
655 - 865	Lime & Shale
865 - 1060	Shale & Lime
1060 - 1570	Lime & Shale
1570 - 2055	Shale & Lime
2055 - 2212	Lime & Shale
2212 - 2554	Shale & Lime
2554 - 2665	Lime, Shale & Sand
2665 - 3208	Shale & Lime
3208 - 3301	Sand & Shale
3301 - 3523	Shale & Lime
3523	K. C. Lime
3523 - 3773	Lime
3773 - 3892	Lime & Shale
3892 - 3945	Lime
3945 - 4009	Lime & Shale
4009 - 4235	Shale & Lime
4235	Miss. Lime
4235 - 4401	Lime
4401 - 4422	Grey Lime
4422 - 4533	Lime
4533 - 4560	Shale
4560 - 4582	Lime & Shale
4582 - 4614	Lime
4614 - 4703	Lime & Shale
4703 - 4729½	Sand & Shale
4729½	T.D.

Cement & Casing Record:

12 Jts. 8 5/8" cemented @ 254'  
with 210 sks. HA 500

PLUGGING RECORD:

Mud	4730 - 240
Cement	240 - 195
Mud	195 - 35
Cement	35 - Surface

Job completed @ 3:00 p.m. 8-4-61

ACKNOWLEDGED:

V. W. McKnab

By Melvin Liebau  
Melvin Liebau

Date: August 9, 1961

RECEIVED  
STATE CORPORATION COMMISSION  
AUG 10 1961  
CONSERVATION DIVISION  
Wichita, Kansas

Subscribed and Sworn to before me this 9th day of August, 1961.

Roberta May  
Notary Public

My commission expires July 31, 1965