


STATE OF KANSAS
STATE CORPORATION COMMISSION

WELL PLUGGING RECORD

Give All Information Completely
Make Required Affidavit
Mail or Deliver Report to:
Conservation Division
State Corporation Commission
212 North Market, Insurance Bldg.
Wichita, Kansas

Sumner County. Sec. 16 Twp. 30S Rge. 1 ~~XXX~~ ~~XXX~~ (W)
Location as "NE/CNW/SW" or footage from lines NW NW SW
Lease Owner Barnett Drilling, Inc.
Lease Name Bell Well No. B-1
Office Address First Nat'l. Bank Bldg. - Wichita, Kansas
Character of Well (completed as Oil, Gas or Dry Hole) Dry hole
Date well completed May 9 19 59
Application for plugging filed May 9 19 59
Application for plugging approved May 9 19 59
Plugging commenced May 9 19 59
Plugging completed May 9 19 59
Reason for abandonment of well or producing formation Dry hole

NORTH

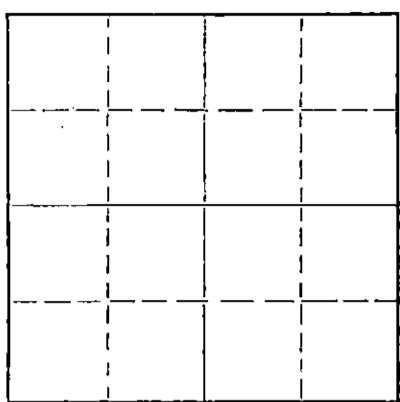

Locate well correctly on above
Section Plat

If a producing well is abandoned, date of last production _____ 19____
Was permission obtained from the Conservation Division or its agents before plugging was commenced? Yes

Name of Conservation Agent who supervised plugging of this well Fred Hambel
Producing formation _____ Depth to top _____ Bottom _____ Total Depth of Well 2926 Feet
Show depth and thickness of all water, oil and gas formations.

OIL, GAS OR WATER RECORDS

CASING RECORD

FORMATION	CONTENT	FROM	TO	SIZE	PUT IN	PULLED OUT
				8 5/8	366'	None

Describe in detail the manner in which the well was plugged, indicating where the mud fluid was placed and the method or methods used in introducing it into the hole. If cement or other plugs were used, state the character of same and depth placed, from _____ feet to _____ feet for each plug set.

Hole filled with heavy rotary mud to 240 ft. Wooden plug at 240 ft. with 15 sacks cement on plug.
Hole filled with heavy rotary mud to 40 ft. Wooden plug at 40 ft. with 10 sacks cement on plug. Rat hole filled with mud and capped with 2 sacks cement.

(If additional description is necessary, use BACK of this sheet)
Name of Plugging Contractor White & Ellis Drilling, Inc. - License #209
Address Box 448 - El Dorado, Kansas

STATE OF Kansas COUNTY OF Butler, ss.
Dale R. Daniel - Employee of Contractor (Employee of owner) or (owner or operator) of the above-described well, being first duly sworn on oath, says: That I have knowledge of the facts, statements, and matters herein contained and the log of the above-described well as filed and that the same are true and correct. So help me God.

(Signature) Dale R. Daniel
Box 448 - El Dorado, Kansas
(Address)

SUBSCRIBED AND SWORN to before me this 11th day of May, 19 59

My commission expires May 21, 1960

Ernest Siffard
Notary Public.

PLUGGING
FILE SEC 16 T. 30 R. 1W
BOOK PAGE 38 LINE 25

Casing Record

Location: NW NW SW
 Section: 16-30S-1W
 Sumner County, Kansas
 Farm: Bell B-1
 Well Owner: Barnett Drilling, Inc.
 Contractor: White & Ellis Drilling
 Started: 5-1-59
 Completed: 5-9-59

8 5/8 366' Cemented
 w/350 sacks

T.D.	3534'
Kelly Bushing measurement - 5 ft. above ground level	
FORMATION	DEPTH
Soil (sandy)	0-30
Shale & Lime	50
Shale	170
Lime	210
Shale & Salt stks.	285
Shale & Lime stks.	360
Antihydrite	366
Antihydrite & Shale stks.	410
Shale & Lime stks.	485
Lime & Shale	570
Shale	620
Red rock	660
Shale & Lime	860
Lime	915
Shale & Lime stks.	975
Lime & Shale	1045
Shale & Lime stks.	1480
Shale	1550
Shale & Lime	1785
Shale	1882
Shale & Lime	2040
Shale	2145
Shale & Lime	2230
Lime	2255
Lime & Shale	2450
Shale	2515
Shale & Red rock	2630
Sand & sdy. Shale	2711
Shale	2765
Shale & Shells	2905
Lime	3132
Shale & Lime	3420
Shale & Lime stks.	3512
Lime	3534

TOPS

Kansas City	2905
Mississippi	3512

Dry Hole
 Plugged & abandoned

PLUGGING
 FILE SEC 16 T 30 R 1W
 BOOK PAGE 38 LINE 25