

R


STATE OF KANSAS
STATE CORPORATION COMMISSION

Give All Information Completely
Make Required Affidavit
Mail or Deliver Report to:
Conservation Division
State Corporation Commission
211 No. Broadway
Wichita, Kansas

WELL PLUGGING RECORD

Sumner County. Sec. 16 Twp. 30S Rge. 1 ~~(E)~~ W (W)
Location as "NE/CNW/SW" or footage from lines CWL SE NW
Lease Owner White & Ellis - et al -
Lease Name Bell Well No. 3
Office Address Box 448, El Dorado, Kansas
Character of Well (completed as Oil, Gas or Dry Hole) Dry Hole
Date well completed 4-28 19 65
Application for plugging filed 4-28 19 65
Application for plugging approved 4-28 19 65
Plugging commenced 4-28 19 65
Plugging completed 4-28 19 65
Reason for abandonment of well or producing formation Dry Hole

NORTH

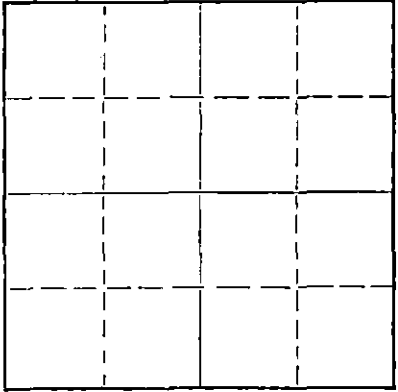

Locate well correctly on above Section Plat

If a producing well is abandoned, date of last production _____ 19____
Was permission obtained from the Conservation Division or its agents before plugging was commenced? yes

Name of Conservation Agent who supervised plugging of this well Howard Hess
Producing formation _____ Depth to top _____ Bottom _____ Total Depth of Well 3570 Feet
Show depth and thickness of all water, oil and gas formations.

OIL, GAS OR WATER RECORDS

CASING RECORD

FORMATION	CONTENT	FROM	TO	SIZE	PUT IN	PULLED OUT
				8 5/8	380'	

Describe in detail the manner in which the well was plugged, indicating where the mud fluid was placed and the method or methods used in introducing it into the hole. If cement or other plugs were used, state the character of same and depth placed, from _____ feet to _____ feet for each plug set.

Hole filled with heavy rotary mud to 250 ft. Bridge at 250 ft. with hulls and 20 sacks cement. Hole pulled with mud to 35 ft. Bridge at 35 ft. with hulls and 8 sacks cement. Rat hole capped with 2 sacks cement.

FILED
STATE CORPORATION COMMISSION
MAY 10 1965
CONSERVATION DIVISION
Wichita, Kansas

(If additional description is necessary, use BACK of this sheet)
Name of Plugging Contractor White & Ellis Drilling, Inc. License # 209
Address Box 448, El Dorado, Kansas

STATE OF Kansas, COUNTY OF Butler, ss.
Ernest Sifford, employee of Contr. _____ (employee or owner) or (owner or operator) of the above-described well, being first duly sworn on oath, says: That I have knowledge of the facts, statements, and matters herein contained and the log of the above-described well as filed and that the same are true and correct. So help me God.

(Signature) Ernest Sifford
Box 448, El Dorado, Kansas
(Address)

SUBSCRIBED AND SWORN TO before me this 7th day of May 1965

My commission expires September 26, 1968 _____ Notary Public.

Casing Record

8 5/8 380' Cemented
w/ 200 sacks

T. D. 3570'

Kelly Bushing Measurement 5' above ground level.

Location: CWL SE NW
Section: 16-30S-1W
Sumner County, Kansas
Farm: Bell # 3
Well Owner: Fred Nixon and
White & Ellis,
Drilling, Inc.
Contractor: White & Ellis,
Drilling, Inc.
Commenced: 4-20-65
Completed: 4-28-65

FORMATION	DEPTH
Cellar	0-7
Shale & Lime stks.	316
Shale & Lime	374
Lime & Shale	855
Lime	1020
Lime & Shale	1065
Shale & Lime	1400
Shale & Lime stks.	1940
Lime & Shale	2180
Shale & Lime stks.	2210
Lime & Shale stks.	2370
Shale & Lime stks.	2500
Shale	2610
Sand	2749
Shale	2941
Lime	3167
Shale	3175
Shale & Lime	3256
Lime & Shale	3500
Shale & Lime stks.	3570

Dry hole, plugged
and abandoned

TOPS

Anyhydrite	374
Stalnaker	2610
Kansas City	2941
Mississippi	3554

RECEIVED
STATE CORPORATION COMMISSION
MAY 10 1965
CONSERVATION DIVISION
Wichita, Kansas