


STATE OF KANSAS
STATE CORPORATION COMMISSION

Form CP-4

Give All Information Completely
Make Required Affidavit
Mail or Deliver Report to:
Conservation Division
State Corporation Commission

WELL PLUGGING RECORD

P. O. Box 17027
Wichita, Kansas 67217
NORTH

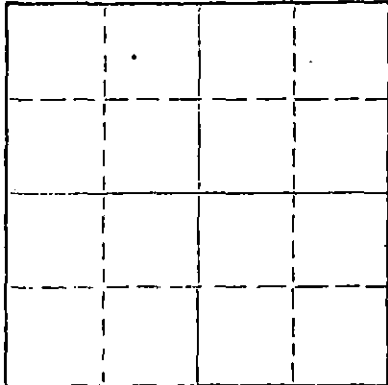

Locate well correctly on above
Section Plat

Sumner County, Sec. 15 Twp. 30 Rge. 1W (E) (W)
Location as "NE/CNWxSWx" or footage from lines SW SE NE
Lease Owner KANSAS PIPE ACCOUNT
Lease Name Chitwood Well No. 2
Office Address 764 Oil Hill Road, El Dorado, KS 67042
Character of Well (completed as Oil, Gas or Dry Hole) Oil
Date well completed September 27 1974
Application for plugging filed September 18 1974
Application for plugging approved September 19 1974
Plugging commenced September 20 1974
Plugging completed September 27 1974
Reason for abandonment of well or producing formation Non-Commercial

If a producing well is abandoned, date of last production 19
Was permission obtained from the Conservation Division or its agents before plugging was commenced? Yes

Name of Conservation Agent who supervised plugging of this well Eugene H. Graham, Box 632, Winfield, KS 67156
Producing formation _____ Depth to top _____ Bottom _____ Total Depth of Well 3880 Feet
Show depth and thickness of all water, oil and gas formations.

OIL, GAS OR WATER RECORDS

CASING RECORD

FORMATION	CONTENT	FROM	TO	SIZE	PUT IN	PULLED OUT
Shale & Lime Shells	275 sks.cm.	260'	307'	10 3/4"	288'	0
Shale & Sand	150 sks.cm.	3874'	3880'	5 1/2"	3875'	2895'

Describe in detail the manner in which the well was plugged, indicating where the mud fluid was placed and the method or methods used in introducing it into the hole. If cement or other plugs were used, state the character of same and depth placed, from 3880 feet to 3850 feet for each plug set.

September - Dumped sand from 3880' to 3850'. Dumped 5 sks. cement from 3850' to 3810' with dump bailer.

September 27 - Made rock bridge from 240' to 230'. Dumped 5 yds. ready mix from 230' to base.

RECEIVED
STATE CORPORATION COMMISSION

OCT 15 1974

CONSERVATION DIVISION
Wichita, Kansas


Name of Plugging Contractor EL DORADO SUPPLY COMPANY
Address 764 Oil Hill Road, El Dorado, KS 67042

STATE OF Kansas, COUNTY OF Sumner, ss.
Orval L. North (employee of owner) or (owner or operator) of the above-described

being duly sworn on oath, says: That I have knowledge of the facts, statements, and matters herein contained and the log of the well as filed and that the same are true and correct. So help me God.

(Signature) Orval L. North
764 Oil Hill Road, El Dorado, KS 67042
(Address)

Subscribed and sworn to before me this 9th day of October, 1974

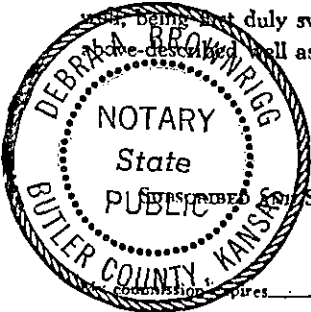

February 12, 1978

Debra A. Brownrigg Notary Public

SULLIVAN ET AL
Chitwood Well No. 2
Total Depth 3880 (rotary)
Drilling comm. 9-29-50
Drilling comp. 10-16-50

SW SE NE Sec. 15 T.30S R.1W
Sumner County, Kansas
Production
Elevation 1248 ESTIMATED

CASING
10" 288' (cemented 275 sks)
5 1/2" 3875' " 150 "

Figures Indicate Bottom of Formations

Soil , shale & sand	70	
shale & lime shells	260	
anhydrite	307	
anhydrite & lime	400	
shale & shells	620	
red bed	650	
shale & shells	945	
lime & shale	1315	
shale & shells	1535	
lime & shale	2430	
shale	2530	
shale & lime	2620	
sand	2668	Top Stalnaker sand 2620
shale	2680	
shale & lime	2830	
shale	2860	
lime	3000	Top Kansas City Line 2860
lime broken	3035	
shale & lime	3120	
shale	3174	
shale & shells	3255	
shale & lime	3325	
shale	3461	
lime	3509	Top Miss. Lime 3461
shale	3550	
lime	3750	
lime & shale	3817	
lime	3845	Top Kinderhook 3845
shale	3874	
sand	3880	Top Simpson sand 3874
Total Depth with rotary	3880	
Sand	3890	
sand and shale	3892	
Total Depth	3892	Plug back 4' with cement

RECEIVED
STATE CORPORATION COMMISSION
SEP 10 1950
CONSERVATION DIVISION
Wichita, Kansas

