


STATE OF KANSAS
STATE CORPORATION COMMISSION

69

Give All Information Completely
Make Required Affidavit
Mail or Deliver Report to:
Conservation Division
State Corporation Commission
211 No. Broadway
Wichita, Kansas

WELL PLUGGING RECORD

Sumner County. Sec. 15 Twp. 30 Rge. 1 (E) W (W)
Location as "NE/CNWxSWx" or footage from lines SE/NW/SE
Lease Owner Woodmen Iannitti Drilling Co.
Lease Name Snyder Well No. A-1
Office Address ### Box 387 Hoisington, Ka.
Character of Well (completed as Oil, Gas or Dry Hole) Oil
Date well completed _____ 19____
Application for plugging filed May 5, 1965
Application for plugging approved May 8, 1965
Plugging commenced May 15, 1965
Plugging completed May 17, 1965
Reason for abandonment of well or producing formation No longer a producer.

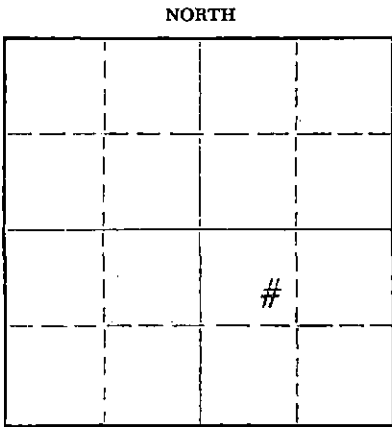

Locate well correctly on above Section Plat

If a producing well is abandoned, date of last production _____ 19____
Was permission obtained from the Conservation Division or its agents before plugging was commenced? Yes

Name of Conservation Agent who supervised plugging of this well Howard Hess
Producing formation _____ Depth to top _____ Bottom _____ Total Depth of Well 3886' Feet
Show depth and thickness of all water, oil and gas formations.

OIL, GAS OR WATER RECORDS

CASING RECORD

FORMATION	CONTENT	FROM	TO	SIZE	PUT IN	PULLED OUT
				8 5/8	325'	None
				5 1/2	3872'	2615'

Describe in detail the manner in which the well was plugged, indicating where the mud fluid was placed and the method or methods used in introducing it into the hole. If cement or other plugs were used, state the character of same and depth placed, from _____ feet to _____ feet for each plug set.
Plugged back with sand from 3886' to 3862'. Mixed and dumped 4 sx. of cement from 3862' to 3830'. Pulled casing. Mudded hole to 220'. Set 20' rock bridge from 220' to 200'. Dumped 2 1/2 yds. of ready mixed cement from 200' to base of the cellar.

RECEIVED
STATE CORPORATION COMMISSION

MAY 28 1965

CONSERVATION DIVISION
Wichita, Kansas

(If additional description is necessary, use BACK of this sheet)

Name of Plugging Contractor Ace Pipe Pulling Co.
Address Box 304 Great Bend, Ks.

STATE OF Kansas, COUNTY OF Barton, ss.
William D. Hoberecht (employee of owner) or (owner or operator) of the above-described well, being first duly sworn on oath, says: That I have knowledge of the facts, statements, and matters herein contained and the log of the above-described well as filed and that the same are true and correct. So help me, God.

(Signature) William D. Hoberecht
Box 304 Great Bend, Ks.
(Address)

SUBSCRIBED AND SWORN to before me this 24th day of May, 1965

My commission expires March 1, 1966
Shuley T. Mann Notary Public.

15-30-1 W 15-191-01347-0000

Kirshner Etal
Snyder Well No. 1 A
Total Depth 3886 (Rotary)
Drilling comm. 6-13-49
Drilling comp. 7-3-49

Sec. 15 T. 30 R. 1 W
SE NW SE
Summer County, Kansas
Elevation 1255
Production Potential 3000 bbls (6500)
Casing
8 5/8
5 1/2 3872' 132 jts 130 sk cement
21 - 7 7/8" rotary bits used

rec'd
8/4/49

Figures Indicate Bottom of Formations

Soil, sand & rock	100	
shale, rock & lime shells	265	
shale	267	
lime shells	313	
anhydrite & lime	395	
shale & shells	475	
shale & lime shells	995	
lime broken	1140	
shale & shells	1550	
lime broken	1680	
shale & lime shells	1845	
lime	2065	
lime & shale	2185	
shale	2209	
shale & shells	2315	
shale & sand	2423	
shale & lime	2498	
shale	2554	
sand	2563	
shale	2575	
shale & sand	2671	
shale & shells	2671	
shale & lime	2735	
shale & shells	2780	
shale & lime	2854	
shale	2865	
lime	3110	Top Kansas City 2865
shale & lime	3175	
lime	3285	
shale & lime	3383	
lime	3435	
shale & lime	3460	
lime (Miss.)	3488	Top Miss. Lime 3460
shale & chert	3505	
lime	3705	
lime	3835	
shale	3871	Kinderhook shale 3835
sand	3886	Top Simpson sand 3871
Total Depth	3886	Rotary

RECEIVED
STATE CORPORATION COMMISSION
MAY 28 1965
CONSERVATION DIVISION
Wichita, Kansas

Top Kansas City 2865

Top Miss. Lime 3460

Kinderhook shale 3835
Top Simpson sand 3871

Well flowed 45 barrels of oil
per hour for 6 hours

2 copies
to Kirshner
8/4/49
1 copy to
Kenshell Log Bureau
8/11/49
J.L.