


STATE OF KANSAS
STATE CORPORATION COMMISSION

Form CP-4

Give All Information Completely
Make Required Affidavit
Mail or Deliver Report to:
Conservation Division
State Corporation Commission
211 No. Broadway
Wichita, Kansas

WELL PLUGGING RECORD

Sumner County. Sec. 15 Twp. 30 Rge. 1 (E) W (W)
Location as "NE/CNW&SW" or footage from lines C-W2/NW/SE
Lease Owner Woodman Iannitti Drilling Co.
Lease Name Snyder Well No. A-2
Office Address Box 387 Hoisington, Ks.
Character of Well (completed as Oil, Gas or Dry Hole) Oil
Date well completed _____ 19____
Application for plugging filed May 5, 1965
Application for plugging approved May 8, 1965
Plugging commenced May 11, 1965
Plugging completed May 13, 1965
Reason for abandonment of well or producing formation No longer a producer.

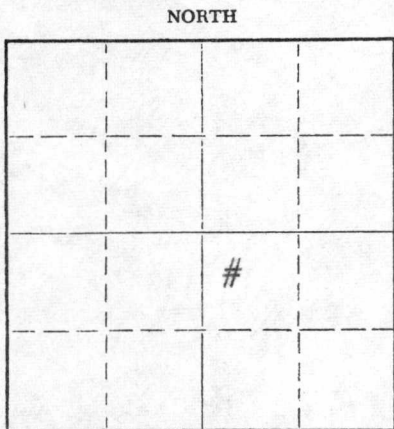

Locate well correctly on above
Section Plat

If a producing well is abandoned, date of last production _____ 19____
Was permission obtained from the Conservation Division or its agents before plugging was commenced? Yes

Name of Conservation Agent who supervised plugging of this well Howard Hess
Producing formation _____ Depth to top _____ Bottom _____ Total Depth of Well 3926 Feet
Show depth and thickness of all water, oil and gas formations.

OIL, GAS OR WATER RECORDS

CASING RECORD

FORMATION	CONTENT	FROM	TO	SIZE	PUT IN	PULLED OUT
				10 3/4	318'	None
				5 1/2	3892'	2615'

Describe in detail the manner in which the well was plugged, indicating where the mud fluid was placed and the method or methods used in introducing it into the hole. If cement or other plugs were used, state the character of same and depth placed, from _____ feet to _____ feet for each plug set.

Plugged back with sand from 3926' to 3885'. Mixed and dumped 4 sx. of cement from 3885' to 3853'. Pulled casing. Mudded hole to 220'. Set 20' rock bridge from 220' to 200'. Dumped 3 1/2 yds. of ready mixed cement from 200' to base of the cellar.

RECEIVED
STATE CORPORATION COMMISSION

MAY 28 1965

CONSERVATION DIVISION
Wichita, Kansas

(If additional description is necessary, use BACK of this sheet)

Name of Plugging Contractor Ace Pipe Pulling Co.
Address Box 304 Great Bend, Ks.

STATE OF Kansas, COUNTY OF Barton, ss.
William D. Hoberecht (employee of owner) or (owner or operator) of the above-described

well, being first duly sworn on oath, says: That I have knowledge of the facts, statements, and matters herein contained and the log of the above-described well as filed and that the same are true and correct. So help me God.

(Signature) William D. Hoberecht

Box 304 Great Bend, Ks.
(Address)

SUBSCRIBED AND SWORN TO before me this 24th day of May, 1965

My commission expires March 1, 1966

Shirley V. Mann
Notary Public.

