


STATE OF KANSAS  
STATE CORPORATION COMMISSION

WELL PLUGGING RECORD

Give All Information Completely  
Make Required Affidavit  
Mail or Deliver Report to:  
Conservation Division  
State Corporation Commission  
211 No. Broadway  
Wichita, Kansas

Summer County. Sec. 14 Twp. 30S Rge. 1W (E) (W)

NORTH

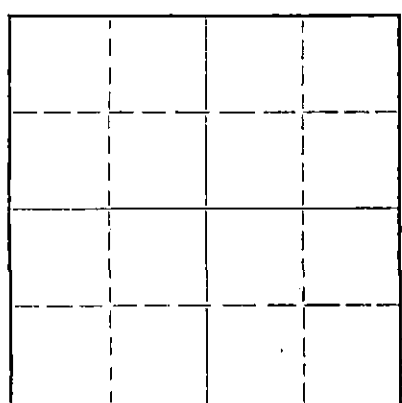

Locate well correctly on above  
Section Plat

Location as "NE/CNW%SW%" or footage from lines SW NW NW  
Lease Owner Brunson Production & Exploration, Inc.  
Lease Name Wade Well No. 1  
Office Address 333 1st Nat'l. Bank Bldg., Wichita, Kansas  
Character of Well (completed as Oil, Gas or Dry Hole) Dry Hole  
Date well completed August 12, 1957 19  
Application for plugging filed August 12, 1957 19  
Application for plugging approved " 19  
Plugging commenced " 19  
Plugging completed " 19  
Reason for abandonment of well or producing formation Dry Hole

If a producing well is abandoned, date of last production 19  
Was permission obtained from the Conservation Division or its agents before plugging was commenced? Yes

Name of Conservation Agent who supervised plugging of this well Eugene Graham  
Producing formation \_\_\_\_\_ Depth to top \_\_\_\_\_ Bottom \_\_\_\_\_ Total Depth of Well 3898 Feet  
Show depth and thickness of all water, oil and gas formations.

OIL, GAS OR WATER RECORDS

CASING RECORD

FORMATION	CONTENT	FROM	TO	SIZE	PUT IN	PULLED OUT
				8 5/8"	342 1/2'	None

Describe in detail the manner in which the well was plugged, indicating where the mud fluid was placed and the method or methods used in introducing it into the hole. If cement or other plugs were used, state the character of same and depth placed, from \_\_\_\_\_ feet to \_\_\_\_\_ feet for each plug set.

Hole circulated with very heavy mud. Laid down drill pipe. Filled hole to 330'. Pushed plug to 330'. Used 15 sacks mix cement. Pushed plug to 40'. Used 10 sacks mixed cement. All plugs secured with two strands of Howco steel line.

(If additional description is necessary, use BACK of this sheet)  
Name of Plugging Contractor Brunson Production & Exploration, Inc.  
Address 333 First National Bank Bldg., Wichita, Kansas

STATE OF Kansas, COUNTY OF Sedgwick, ss.  
I, Ralph B. McLaughlin (employee of owner) or (owner) of the above-described well, being first duly sworn on oath, says: That I have knowledge of the facts, statements, and matters herein contained and the log of the above-described well as filed and that the same are true and correct. So help me God.

(Signature) *Ralph B. McLaughlin*  
(Address)

SUBSCRIBED AND SWORN TO before me this 26th day of August, 19 57

My commission expires July 1, 1961  
Anna M. Wedan Notary Public.  
STATE CORPORATION COMMISSION

PLUGGING  
FILE SEC 14 T. 30 R. 1W  
BOOK PAGE 97 LINE 17

AUG 28 1957  
8-28-57  
CONSERVATION DIVISION  
Wichita, Kansas

AUG 28 1957  
CONSERVATION DIVISION  
Wichita, Kansas

15-191-0469-0000

BRUNSON PRODUCTION & EXPLORATION, INC.  
WICHITA, KANSAS

WELL: WADE # 1

SW NW NW

COMMENCED RD: 7-31-57

14-30S-1W

COMPLETED RD: 8-12-57

SUMNER COUNTY, KANSAS

TOTAL DEPTH: 3898'

ELEVATION: 1227' Gr.

CASING: 342 1/2' 8 5/8" O. D. 28 1/2#

CONTRACTOR: BRUNSON  
PRODUCTION & EXPLORATION, INC.

STRATA	DEPTH	TOPS
Surface Soil & Clay	65	Kansas City 2829 (-1598)
Shale & Shells	200	Mississippian Limestone
Shale & Anhydrite	235	3435 (-2204)
Anhydrite	360	Kinderhook 3814 (-2583)
Shale	397	Simpson 3884 (-2653)
Shale & Lime	578	
Red Bed	585	
Lime	638	
Shale & Lime	820	
Shale	830	
Red Bed	840	
Lime & Shale	1220	
Shale	1505	
Shale & Lime	2193	
Shale	2860	
Lime	2935	
Shale & Lime	3115	
Shale, Lime & Chert	3487	
Lime & Shale	3536	
Lime, Shale & Chert	3592	
Lime & Shale	3668	
Lime, Shale & Chert	3700	
Lime & Shale	3898	
Total Depth	3898	

I hereby certify that the above is a true and correct log of said well as reflected by the daily drilling report.

BRUNSON PRODUCTION & EXPLORATION, INC.  
BY

*Ralph B. McLaughlin*  
Ralph B. McLaughlin-Secretary-Treas.

Signed and sworn to in my presence this 26th day of August, 1957, by Ralph B. McLaughlin, Secretary-Treasurer of Brunson Production & Exploration, Inc., a Corporation in the State of Kansas.

*Anna M. Wedan*  
Anna M. Wedan-Notary Public

My commission expires July 1, 1961.

PLUGGING  
FILE SEC. 14 T 30 R 1W  
BOOK PAGE 31 LINE 17