

STATE CORPORATION COMMISSION OF KANSAS
OIL & GAS CONSERVATION DIVISION
WELL COMPLETION OR RECOMPLETION FORM
ACO-1 WELL HISTORY
DESCRIPTION OF WELL AND LEASE

API NO. 15-189-21-373-00-00

County STEVENS

NE SW SW Sec 23 Twp 34 S Rge 36 East X West

Operator: License # 4335
Name ENRIGHT GAS & OIL/TERRAL ENERGY
Address 3245 BROADWAY
City/State/Zip BOULDER, CO 80304

990 Ft North from Southeast Corner of Section
4290 Ft West from Southeast Corner of Section
(Note: Locate well in section plat below)

Purchaser MOBIL NATURAL GAS

Lease Name ELLIS Well # 2-23

Field Name NORTHWEST SKI


Operator Contact Person TERRY D. ENRIGHT
Phone 303-444-4545

Producing Formation LOWER MORROW

Elevation: Ground 3046 KB 3058

Contractor: License # 2087
Name R & C DRILLING CO., INC.

Section Plat

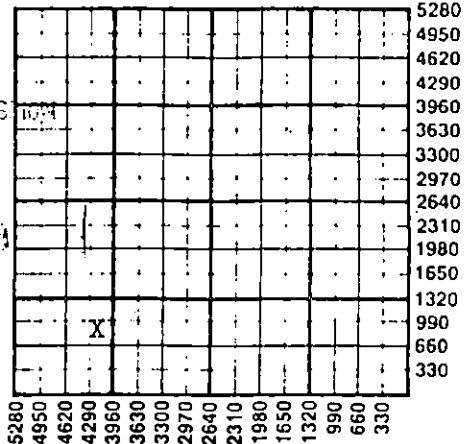

Wellsite Geologist JACK HICKEY
Phone 303-447-1135

Designate Type of Completion
X New Well Re-Entry Workover
Oil SWD Temp Abd
X Gas Inj Delayed Comp.
Dry Other (Core, Water Supply etc.)

If CWNO: old well info as follows:
Operator
Well Name
Comp. Date Old Total Depth

WATER SUPPLY INFORMATION

Disposition of Produced Water: X Disposal
Docket # Repressuring

WELL HISTORY

Drilling Method:
X Mud Rotary Air Rotary Cable

8/10/89 8/22/89 10/4/89
Spud Date Date Reached TD Completion Date
6729 6684
Total Depth PBTD

Amount of Surface Pipe Set and Cemented at 1747 feet
Multiple Stage Cementing Collar Used? X Yes No
If yes, show depth set 3389 feet
If alternate 2 completion, cement circulated from 3389 feet depth to 1747 w/ SX cmt
Cement Company Name Dowell Schlumberger
Invoice # 03-12-1964

Questions on this portion of the ACO-1 call:

Water Resources Board (913) 296-3717

Source of Water:
Division of Water Resources Permit #

X Groundwater 990 Ft North from Southeast Corner
(Well) 4290 Ft West from Southeast Corner of
Sec 23 Twp 34 S Rge 36 East X West

Surface Water Ft North from Southeast Corner
(Stream, pond etc) Ft West from Southeast Corner
Sec Twp Rge East West

Other (explain)
(purchased from city, R.W.D. #)

INSTRUCTIONS: This form shall be completed in triplicate and filed with the Kansas Corporation Commission, 200 Colorado Derby Building, Wichita, Kansas 67202, within 120 days of the spud date of any well. Rule 82-3-130, 82-3-107 and 82-3-106 apply. Information on side two of this form will be held confidential for a period of 12 months if requested in writing and submitted with the form. See rule 82-3-107 for confidentiality in excess of 12 months. One copy of all wireline logs and drillers time log shall be attached with this form. Submit CP-4 form with all plugged wells. Submit CP-111 form with all temporarily abandoned wells.

All requirements of the statutes, rules and regulations promulgated to regulate the oil and gas industry have been fully complied with and the statements herein are complete and correct to the best of my knowledge.

Signature Terry D. Enright
Title PRESIDENT Date 11/15/89

Subscribed and sworn to before me this 17th day of November 1989
Notary Public

Date Commission Expires 1/20/93

K.C.C. OFFICE USE ONLY
Letter of Confidentiality Attached
Wireline Log Received
Drillers Timelog Received
Distribution
KCC SWD/Rep NGPA
KGS Plug Other
(Specify)

pl