


Give All Information Completely
Make Required Affidavit
Mail or Deliver Report to:
Conservation Division
State Corporation Commission
211 No. Broadway
Wichita, Kansas

WELL PLUGGING RECORD

Morton County. Sec. 17 Twp. 33S Rge. (E) 41 (W)
Location as "NE/CNWxSWx" or footage from lines C SE NW
Lease Owner The R. W. Rine Drilling Company
Lease Name Murphy Well No. 1
Office Address 420 Union Center
Character of Well (completed as Oil, Gas or Dry Hole) Dry Hole
Date well completed January 5, 19 63
Application for plugging filed January 5, 19 63
Application for plugging approved January 5, 19 63
Plugging commenced January 6, 19 63
Plugging completed January 6, 19 63
Reason for abandonment of well or producing formation Dry Hole

NORTH

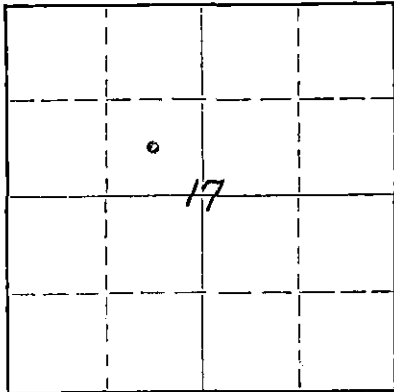

Locate well correctly on above
Section Plat

If a producing well is abandoned, date of last production 19
Was permission obtained from the Conservation Division or its agents before plugging was commenced? Yes

Name of Conservation Agent who supervised plugging of this well Hugh Scott
Producing formation Depth to top Bottom Total Depth of Well 5398 Feet
Show depth and thickness of all water, oil and gas formations.

OIL, GAS OR WATER RECORDS

CASING RECORD

FORMATION	CONTENT	FROM	TO	SIZE	PUT IN	PULLED OUT
				8-5/8"	1490'	

Describe in detail the manner in which the well was plugged, indicating where the mud fluid was placed and the method or methods used in introducing it into the hole. If cement or other plugs were used, state the character of same and depth placed, from feet to feet for each plug set.

Plugged with heavy mud from 5398 to 750 feet.
Ran 35 sacks regular cement through open end drill pipe at 750 feet.
Heavy mud to 40 feet.
1/2 sack hulls and 15 sacks regular cement from 40 feet to bottom of cellar.

RECEIVED
STATE CORPORATION COMMISSION

MAR 1 1963

WICHITA, KANSAS

(If additional description is necessary, use BACK of this sheet)

Name of Plugging Contractor THE R. W. RINE DRILLING COMPANY
Address 420 Union Center, Wichita 2, Kansas

STATE OF KANSAS, COUNTY OF SEDGWICK, ss.
R. M. Green (employee of owner) or (owner or operator) of the above-described

well, being first duly sworn on oath, says: That I have knowledge of the facts, statements, and matters herein contained and the log of the above-described well as filed and that the same are true and correct. So help me God.

(Signature) R. M. Green
420 Union Center, Wichita 2, Kansas
(Address)

SUBSCRIBED AND SWORN TO before me this 25TH day of FEBRUARY, 19 63

My commission expires MAY 15, 1966

Vera M. Hull
Notary Public.



15-129-00165-0000

C SE NW
Section 17-33S-41W
Morton County, Kansas

MURPHY WELL NO. 1

Contractor: The R. W. Rine Drilling Company

STARTED: December 20, 1962

COMPLETED: January 6, 1963

	L	O	G
Sand & Red Bed	0'	-	369'
Red Bed & Anhydrite	369'	-	1500'
Anhydrite & Shale	1500'	-	1664'
Shale & Red Bed	1664'	-	1762'
Lime & Shale	1762'	-	2215'
Lime	2215'	-	2300'
Lime & Shale	2300'	-	2748'
Shale & Chalk	2748'	-	3025'
Lime	3025'	-	3224'
Lime & Shale	3224'	-	3316'
Lime	3316'	-	3488'
Lime & Shale	3488'	-	3596'
Lime	3596'	-	3862'
Lime & Shale	3862'	-	4987'
Sand & Shale	4987'	-	5050'
Shale & Lime	5050'	-	5226'
Shale & Sand	5226'	-	5285'
Lime	5285'	-	5398'

Totco @100', 1/4°
Totco @1500', 3/4°-8-5/8" Csg.
@1496' w/425 Sx. lt. wt. followed
w/200 sx. reg. all 2% C. C.

Totco @2295', 1°
Totco @2690', 3/4°

Totco @4080', 3/4°

T. D. Plugged @750' W/35 sx. reg.
cement and @ 40' w/1/2 sx. hulls
and 15 sx. reg.

STATE OF KANSAS)
COUNTY OF SEDGWICK) ss


I, R. M. Green, do hereby certify that the above is a true and accurate log of the
Murphy Well No. 1, located SE NW of Section 17-33S-41W, Morton County, Kansas.


Secretary-Treasurer

Subscribed and sworn to before me this 10th day of January, 1963.

RECEIVED
STATE CORPORATION COMMISSION

MAR 1 1963

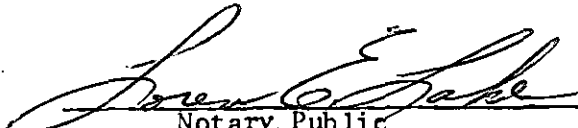
Notary Public

My Commission Expires: 6/14/66
CONSERVATION DIVISION
Wichita, Kansas