


STATE OF KANSAS
STATE CORPORATION COMMISSION

Form CP-4

Give All Information Completely
Make Required Affidavit
Mail or Deliver Report to:
Conservation Division
State Corporation Commission
212 No. Market
Wichita, Kansas

WELL PLUGGING RECORD

Morton County, Sec. 18 Twp. 33S Rge. (E) 41 (W)
Location as "NE/CNW/SW" or footage from lines C NW SW
Lease Owner Pickrell Drilling Company
Lease Name White "A" Well No. 1
Office Address 705 4th National Bank Bldg.
Character of Well (completed as Oil, Gas or Dry Hole) Dry Hole
Date well completed May 17, 19 68
Application for plugging filed May 17, 19 68
Application for plugging approved May 17, 19 68
Plugging commenced May 17, 19 68
Plugging completed May 17, 19 68
Reason for abandonment of well or producing formation Dry Hole

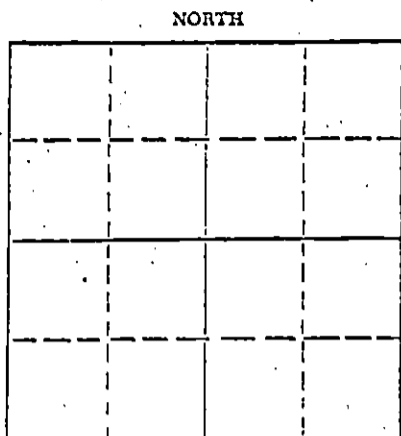

Locate well correctly on above Section Plat

If a producing well is abandoned, date of last production 19
Was permission obtained from the Conservation Division or its agents before plugging was commenced? Yes

Name of Conservation Agent who supervised plugging of this well Edgar J. Eves, Sublette, Kansas
Producing formation Depth to top Bottom Total Depth of Well 5455 Feet
Show depth and thickness of all water, oil and gas formations.

OIL, GAS OR WATER RECORDS

CASING RECORD

FORMATION	CONTENT	FROM	TO	SIZE	PUT IN	PULLED OUT
				8 5/8"	1485'	None

Describe in detail the manner in which the well was plugged, indicating where the mud fluid was placed and the method or methods used in introducing it into the hole. If cement or other plugs were used, state the character of same and depth placed, from feet to feet for each plug set.

Heavy mud to 900'. Set plug. Cemented with 35 sacks cement. Heavy mud to 45'. Set plug. Cemented with 15 sacks cement to bottom of cellar. Plugged rat hole with 2 sacks cement.

RECEIVED
STATE CORPORATION COMMISSION
MAY 27 1968
CONSERVATION DIVISION
Wichita, Kansas

(If additional description is necessary, use BACK of this sheet)
Name of Plugging Contractor Pickrell Drilling Company
Address 705 4th National Bank Building, Wichita 2, Kansas

STATE OF KANSAS, COUNTY OF SEDGWICK, ss.
C. W. SEBITS (employee of owner) or (owner or operator) of the above-described

well, being first duly sworn on oath, says: That I have knowledge of the facts, statements, and matters herein contained and the log of the above-described well as filed and that the same are true and correct. So help me God.

(Signature) C. W. Sebits
705 4th National Bank Building, Wichita 2, Kans.
(Address)


Subscribed AND Sworn to before me this 23rd day of May, 19 68

My commission expires

May 10, 1970

L. M. Whiting

Notary Public.

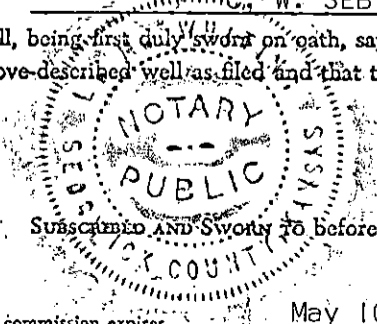

ROTARY DRILLING LOG

COMPANY: PICKRELL DRILLING COMPANY
705 4th National Bank Bldg.
Wichita, Kansas

Rotary Drilling Commenced 4/30/68

Rotary Drilling Completed 5/17/68

LOCATION: White "A" No. 1, C NW SW Section 18-33S-41W, Morton County, Kansas.

CONTRACTOR: **PICKRELL DRILLING COMPANY**
Wichita, Kansas

CASING RECORD: (37 jts) 8 5/8" surface casing set at 1485', cemented with 675 sacks cement. Circulated. Completed 1:15 PM May 2, 1968. No oil string run. D & A plugged at 5:30 AM May 17, 1968.

LOG

(Figures indicate bottom of formation — measurements from top of rotary bushing.)

540	Clay & Sandy Clay	C.F.S.
930	Red Shale & Shells	
1065	Red Sandy Shale	3296
1068	Anhydrite	4975
1305	Sand	5045
1475	Sandy Shale	5290
1530	Anhydrite	5455
1720	Shale & Lime	
2175	Shale & Red Beds	
2565	Shale & Lime	Slope Tests
2730	Lime	2500
4025	Lime & Shale	3000
4140	Lime	3500
4935	Shale & Lime	4000
4975	Shale, Lime & Sand	4500
4985	Sand & Shale	5000
5000	Sand	
5120	Shale & Sandy Shale	
5192	Lime & Sand	S. L. M.
5270	Lime, Shale & Sand	
5356	Sand & Shale	Board 3026.84
5395	Lime, Shale & Sand	Strap 3025.93
5402	Sand & Shale	
5428	Miss Shale & Lime	
5455	Mississippian RTD	

RECEIVED
STATE CORPORATION COMMISSION
MAY 27 1968
CONSERVATION DIVISION
Wichita, Kansas

The undersigned, C. W. SEBITS, Attorney-in-Fact for PICKRELL DRILLING COMPANY, hereby certifies in behalf of said Company, that the above is a true and correct log of the formation encountered in drilling the above well as reflected by the Daily Drilling Reports.

PICKRELL DRILLING COMPANY

By [Signature]
C. W. SEBITS Attorney-in-Fact

STATE OF KANSAS }
COUNTY OF SEDGWICK } ss.:

On this 23rd day of May, 1968, before me the undersigned, a Notary Public, in and for the County and State aforesaid, personally appeared C. W. SEBITS, to me known to be the identical person who subscribed the name of PICKRELL DRILLING COMPANY to the foregoing instrument as its Attorney-in-Fact, and acknowledged to me that he executed the same as his free and voluntary act and deed, and as the free and voluntary act and deed of such company, for the uses and purposes therein set forth.

Given under my hand and seal of office the day and year last above written.

My commission expires: May 10, 1970

[Signature]
L. M. Whiting, Notary Public