


P

WELL PLUGGING RECORD

Give All Information Completely  
Make Required Affidavit  
Mail or Deliver Report to:  
Conservation Division  
State Corporation Commission  
211 No. Broadway  
Wichita, Kansas

NORTH

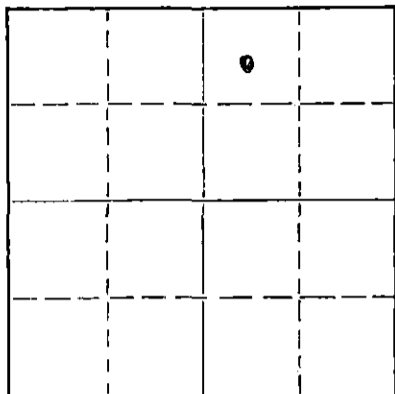

Locate well correctly on above  
Section Plat

Morton County, Sec. 18 Twp. 335 Rge. 41 (E) (W)  
Location as "NE/CNW/SW" or footage from lines G-NW 1/4-NE 1/4  
Lease Owner Sidwell Oil and Gas Inc.  
Lease Name Borth Well No. 1  
Office Address Box 2475 Pampa, Texas  
Character of Well (completed as Oil, Gas or Dry Hole) Oil  
Date well completed 10-1 19 65  
Application for plugging filed 7-11 19 68  
Application for plugging approved 7-24 19 68  
Plugging commenced 7-26 19 68  
Plugging completed 7-27 19 68  
Reason for abandonment of well or producing formation Not Economical

If a producing well is abandoned, date of last production 2-25 19 68  
Was permission obtained from the Conservation Division or its agents before plugging was commenced? Yes

Name of Conservation Agent who supervised plugging of this well Ed Eaves and Bill Granell  
Producing formation Upper Morrow Depth to top 4998 Bottom 5011 Total Depth of Well 5435 Feet  
Show depth and thickness of all water, oil and gas formations.

OIL, GAS OR WATER RECORDS

CASING RECORD

FORMATION	CONTENT	FROM	TO	SIZE	PUT IN	PULLED OUT
Anhydrite		1427	1530	8 5/8"	1491	-0-
Morrow sand and G. Sand		4998	5268	4 1/2"	5148	3430

Describe in detail the manner in which the well was plugged, indicating where the mud fluid was placed and the method or methods used in introducing it into the hole. If cement or other plugs were used, state the character of same and depth placed, from \_\_\_\_\_ feet to \_\_\_\_\_ feet for each plug set.

Mixed and pumped 20 sacks cement (common) w/wiper plug from 4500' to 4740' to cover perfs. at 4998'.  
Shot 4 1/2" casing free at 3430' and pulled casing to 700'.  
Establish circulation with mud and spot 35 sacks common cement from 600' to 700'.  
Pull remainder of 4 1/2" casing. Run 10 sacks cement from 3' to 33' and capped with steel plate.

RECEIVED  
STATE CORPORATION COMMISSION  
AUG 1 1968  
CONSERVATION DIVISION  
Wichita, Kansas

(If additional description is necessary, use BACK of this sheet)  
Name of Plugging Contractor Daco Lease and Well Service (License) # 138  
Address 1700 South Main Borger, Texas 79007

STATE OF Texas, COUNTY OF Hutchinson, ss.  
Ken D. Davis (employee of owner) or (~~Ken D. Davis~~) of the above-described well, being first duly sworn on oath, says: That I have knowledge of the facts, statements, and matters herein contained and the log of the above-described well as filed and that the same are true and correct. So help me God.  
(Signature) Ken D. Davis  
1700 South Main Borger, Texas 79007  
(Address)

SUBSCRIBED AND SWORN TO before me this 30 day of July, 19 68

My commission expires 6-1-69  
Rena R. Bonds  
Notary Public.

Well Log  
Borth #1

15-129-30071-0000

Location: NW <sup>NE</sup> Sec. 18-33S-41W, Morton County, Kansas  
Operator: Sidwell Oil & Gas Inc.  
P.O. Box 2475  
Pampa, Texas 79066  
Contractor: Holm Drilling Company  
P.O. Box 7505, Southside Station  
Tulsa, Oklahoma 74105

Commenced: 8-18-65 Spudded: 8-20-65 Completed: 9-7-65

Hole  
Rotary/Depth: 5435' K.B. Measure = 5425' Ground Level Measure

Casing Record: 5140' 4 1/2"

Formation	Depth
Surface Sand	430'
Red Bed & Surface Sand	541'
Shale & Gyp	1102'
Sand	1230'
Shale & Gyp	1480'
Red Bed & Shale	1490'
Red Bed	1575'
Red Bed & Clay	2070'
Red Bed & Shale	2290'
Shale	2310'
Shale & Lime	2558'
Shale	2635'
Shale & Lime	2684'
Shale	2722'
Shale & Lime	2857'
Shale	3192'
Shale & Lime	3220'
Shale	3325'
Lime & Shale	3495'
Shale & Lime	3528'
Lime & Shale	3639'
Lime W/Shale streaks	4315'
Lime & Shale	4341'
Lime	4680'
Lime & Shale	4687'
Shale	4999'
Sand	5010'
Shale	5062'
Shale & Sand	5260'
Lime & Shale	5284'
Shale & Sand	5348'
Sand & Lime "Keyes"	5392'
Sand & Lime	5397'
Shale & Sand	5435' T.D.

RECEIVED  
STATE CORPORATION COMMISSION

JUL 19 1968  
CONSERVATION DIVISION  
Wichita, Kansas

The undersigned hereby certifies that the above is a true and correct copy of the Driller's Log.

By:   
J. C. Hatfield - Vice-Pres. & Treas of  
Holm Drilling Company