

STATE OF KANSAS
STATE CORPORATION COMMISSION


Give All Information Completely
Make Required Affidavit
Mail or Deliver Report to:
Conservation Division
State Corporation Commission
211 No. Broadway
Wichita, Kansas

WELL PLUGGING RECORD

Sumner County, Sec. 13 Twp. 30S Rge. (E) 1 (W)

Location as "NE/CNW/SW" or footage from lines C SW SE
Lease Owner White & Ellis et al
Lease Name Walton Well No. 1
Office Address P. O. Box 448, El Dorado, Kansas
Character of Well (completed as Oil, Gas or Dry Hole) Dry Hole
Date well completed Dec. 8, 1961
Application for plugging filed Dec. 8, 1961
Application for plugging approved Dec. 8, 1961
Plugging commenced Dec. 8, 1961
Plugging completed Dec. 8, 1961
Reason for abandonment of well or producing formation Dry Hole

NORTH

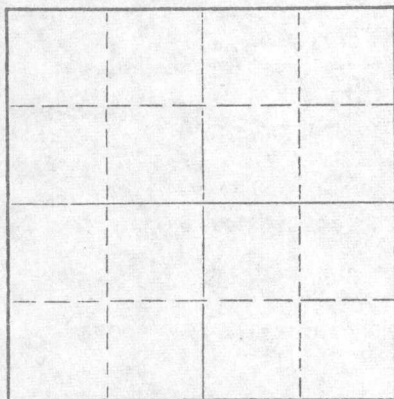

Locate well correctly on above Section Plat

If a producing well is abandoned, date of last production 19
Was permission obtained from the Conservation Division or its agents before plugging was commenced? Yes

Name of Conservation Agent who supervised plugging of this well Eugene Graham
Producing formation _____ Depth to top _____ Bottom _____ Total Depth of Well 3890 Feet
Show depth and thickness of all water, oil and gas formations.

OIL, GAS OR WATER RECORDS

CASING RECORD

FORMATION	CONTENT	FROM	TO	SIZE	PUT IN	PULLED OUT
				8 5/8	304'	None

Describe in detail the manner in which the well was plugged, indicating where the mud fluid was placed and the method or methods used in introducing it into the hole. If cement or other plugs were used, state the character of same and depth placed, from _____ feet to _____ feet for each plug set.

Hole filled with heavy rotary mud to 240 ft. Bridge at 240 ft., dumped hulls & 20 sacks cement thru drill pipe. Mud to 30 ft., plug at 30 ft., dumped hulls & 8 sacks cement. Dumped hulls & 2 sacks cement in rat hole.

RECEIVED
STATE CORPORATION COMMISSION
DEC 14 1961
CONSERVATION DIVISION
Wichita, Kansas

(If additional description is necessary, use BACK of this sheet)

Name of Plugging Contractor White & Ellis Drilling, Inc. - License #209
Address Box 448, El Dorado, Kansas

STATE OF Kansas COUNTY OF Butler, ss.
Ernest Sifford, employee of Contractor (employee of owner) or (owner or operator) of the above-described well, being first duly sworn on oath, says: That I have knowledge of the facts, statements, and matters herein contained and the log of the above-described well as filed and that the same are true and correct. So help me God.

(Signature) Ernest Sifford
Box 448, El Dorado, Kansas
(Address)

SUBSCRIBED AND SWORN TO before me this 12th day of December, 1961

My commission expires September 26, 1964
L. B. Auer
Notary Public.



Casing Record

8 5/8

304' Cemented
w/225 sacks

15-191-00128-0000

Location: C SW SE

Section: 13-30S-1W

Sumner County, Kansas

Farm: Walton #1

Well Owner: Nixon & Bear

Contractor: White & Ellis Drilg., Inc.

Started: 11/14/61

Completed: 12/8/61



T.D. 3890'
Kelly Bushing Measurement 5' above ground level.

FORMATION	DEPTH
Soil	0-55
Shale	220
Lime	240
Anhydrite	780
Lime & Shale	1100
Shale & Lime stks.	1500
Shale & Shells	1700
Lime & Shale	2300
Shale & Lime	2483
Shale	2816
Lime	3045
Shale	3077
Lime	3095
Lime & Shale	3278
Shale & Lime	3268
Shale	3419
Lime	3787
Shale	3861
Sand	3890

TOPS

Stalnaker (lime)	2485
Stalnaker (sand)	2500
Kansas City	2820
B/Kansas City	3046
Marmaton	3129
Mississippi	3419
Kinderhook	3787
Simpson	3861

RECEIVED
STATE CORPORATION COMMISSION

DEC 14 1961

CONSERVATION DIVISION
Wichita, Kansas