

STATE OF KANSAS
STATE CORPORATION COMMISSION

WELL PLUGGING RECORD


Give All Information Completely
Make Required Affidavit
Mail or Deliver Report to:
Conservation Division
State Corporation Commission
800 Bitting Building
Wichita, Kansas

OR
FORMATION PLUGGING RECORD

Strike out upper line
when reporting plugging
off formations.

Sumner County, Sec. 12 Twp. 30 Rge. 1 (E) 1 (W)

Location as "NE $\frac{1}{4}$ NW $\frac{1}{4}$ SW $\frac{1}{4}$ " or footage from lines W $\frac{1}{2}$ -NW-SW-SE
Lease Owner Plains Exploration Company
Lease Name Long Well No. 3
Office Address Denver 2, Colorado
Character of Well (completed as Oil, Gas or Dry Hole) Dry hole
Date well completed 9-16-50 19
Application for plugging filed 9-17-50 19
Application for plugging approved 9-17-50 19
Plugging commenced 9-18-50 19
Plugging completed 9-23-50 19
Reason for abandonment of well or producing formation Dry hole

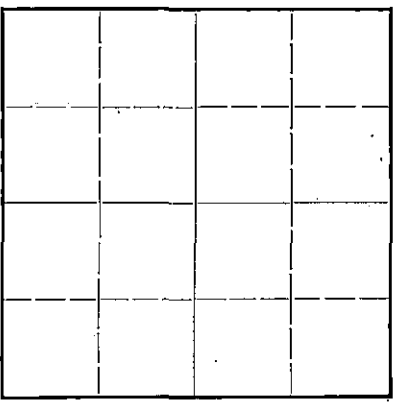

Locate well correctly on above
Section Plat

If a producing well is abandoned, date of last production 19
Was permission obtained from the Conservation Division or its agents before plugging was commenced? Yes

Name of Conservation Agent who supervised plugging of this well Mr. W. G. Buffington
Producing formation Depth to top Bottom Total Depth of Well 3955 Feet

Show depth and thickness of all water, oil and gas formations.
OIL, GAS OR WATER RECORDS CASING RECORD

Formation	Content	From	To	Size	Put In	Pulled Out
				8 5/8"	245'	None
				5 1/2"	3862'	3406'

Describe in detail the manner in which the well was plugged, indicating where the mud fluid was placed and the method or methods used in introducing it into the hold. If cement or other plugs were used, state the character of same and depth placed, from feet to feet for each plug set.

Plugged back from 3955' to 3830' with Crushed Rock.
Dumped 4 sacks cement with bailer.
Shot pipe off at 3406'. Halliburton circulated heavy mud.
Placed wood plug at 260'.
Filled hole to 245' with crushed rock.
Dumped 15 sacks of cement.
Filled hole with heavy mud to 24' below bottom of cellar.
Filled to bottom of cellar with cement.

RECEIVED
STATE CORPORATION COMMISSION
OCT 13 1950
CONSERVATION DIVISION
Wichita, Kansas

(If additional description is necessary, use BACK of this sheet)
Correspondence regarding this well should be addressed to Plains Exploration Company
Address 524 University Building
Denver 2, Colorado.

STATE OF Kansas, COUNTY OF Stafford, ss.
E. E. Duncan (employee of owner) or (owner or operator) of the above-described well,

being first duly sworn on oath, says: That I have knowledge of the facts, statements, and matters herein contained and the log of the above-described well as filed and that the same are true and correct. So help me God.


(Signature) E. E. Duncan

Stafford, Kansas (Address)

SUBSCRIBED AND SWORN to before me this 25 day of September, 1950.

My commission expires Aug 4 - 1954

[Signature]
Notary Public.

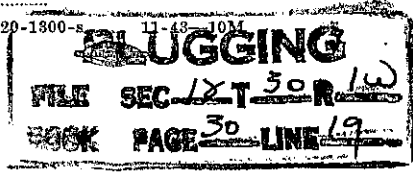

PLAINS EXPLORATION COMPANY

DRILLERS WELL LOG

LONG NO. 3

Company	Plains Exploration Company	Section	12 T. 30S R. 1W
Farm	Long	Location	W1/2-NW-SW-SE
Total Depth	3955'	County	Sumner
Commenced	8-23-50	Production	Dry hole
Completed	9-16-50		
Shot or Treated	None		
Contractor	Sterling Drilling Company		

CASING RECORD

8 5/8" set at 245' Cemented with 150 sacks plus 30 sacks cementing from top.

5 1/2" Set at 3862' Cemented with 75 sacks.

All measurements carried from Kelly Bushing.
Kelly Bushing 7 1/2' above top of spider.

0'	Kelly Bushing	Geologists Tops	
65'	Clay, Sand and Shell		
200'	Shale and Sand	Simpson	3861'
245'	Shale and Shell	Arbuckle	3943'
305'	Shale and Clay		
770'	Lime and Shale		
2240'	Shale and Lime		
2335'	Shale		
2630'	Shale and Lime		
2675'	Shale		
2820'	Shale and Lime		
3115'	Lime		
3175'	Lime and Shale		
3230'	Lime		
3330'	Lime and Shale		
3425'	Shale and Lime		
3635'	Lime		
3665'	Lime and Shale		
3770'	Lime		
3850'	Lime and Shale		
3861'	Shale		
3865'	Simpson Sand		
	Rotary T. D.		
3868'	Sand		
3885'	Sand and Shale		
3890'	Grey Shale		
3897'	Shale and Sand		
3909'	Shale dark grey		
3919'	Shale, Streaks and Sand		
3935'	Sand		
3943'	Green Shale		
3955'	Arbuckle Lime		
	T. D.		

RECEIVED
STATE CORPORATION COMMISSION
SEP 26 1950
CONSERVATION DIVISION
Wichita, Kansas

TESTING AND ACIDIZING REPORT

No show of oil or gas while cleaning out to bottom and drilling to 3890'. Fair looking sand from 3890' to 3895'. Some free oil showed up after hole setting for 15 hours. No show of formation water. Possibly 5 galls. of nice clean free oil in 24 hours, no increase of fluid while drilling to 3909'. Approximately 5 galls. of water per hour from 3909' to 3919', no increase in oil. No increase of oil or water while drilling to 3950'. 1950' fill up of water no noticeable increase of oil while drilling from 3950' to 3955', approximately 45 minutes time.

I HEREBY CERTIFY THE ABOVE RECORD IS A TRUE AND CORRECT RECORD OF THE DRILLERS LOG OF THIS WELL.

Subscribed and sworn to before me this 18 day of Sept. 1950
My commission expires

PLUGGING
PAGE SEC 17 T 30 R 1W
BOOK PAGE 30 LINE 19

3953 - water

Reck to 3830 then dumped. 4 sack cement.

that pips off. 3406 - mudded - Bottom.

4 surface - set plug wood plug & dumped.

15 sacks mudded to 15 ft of top.

RECEIVED

