

15-007-10363-0000

RECEIVED

STATE OF KANSAS
STATE CORPORATION COMMISSION

Give All Information Completely
Make Required Affidavit
Mail or Deliver Report to:
Conservation Division
State Corporation Commission,
800 Bittling Building
Wichita, Kansas

WELL PLUGGING RECORD
OR
FORMATION PLUGGING RECORD

NOV 2 1937

Strike out upper line
when reporting plug-
ging off formations.

County. Sec. 18, Twp. 34 Rge. 13 (W)

Location as "NE 1/4 NW 1/4 SW 1/4" or footage from lines 300 ft

Lease Owner Colonial Oil Co

Lease Name Blank Well No. 1

Office Address

Character of Well (Completed as Oil, Gas or Dry Hole) Dry Hole

Date, well completed Oct 27 1937

Application for plugging filed Oct 28 1937

Application for plugging approved Oct 28 1937

Plugging Commenced Oct 28 - at 10 A.M. 1937


Plugging Completed Oct 28 - at 3 P.M. 1937

Reason for abandonment of well or producing formation Dry Hole

If a producing well is abandoned, date of last production X 1937

Was permission obtained from the Conservation Division or its agents before plugging was commenced? Yes

NORTH

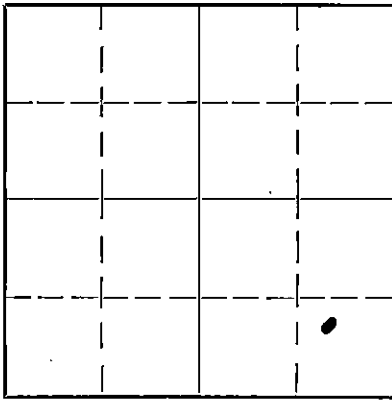

Locate well correctly on above Section Plat

Name of Conservation Agent who supervised plugging of this well X

Producing formation X Depth to top X Bottom X Total Depth of Well 540.5 Feet

Show depth and thickness of all water, oil and gas formations.

OIL, GAS OR WATER RECORDS

CASING RECORD

Formation	Content	From	To	Size	Put In	Pulled Out
Water sand	Fresh water	2.00	2.20	10 1/2	2.20	X
Mass Clay	no show	2.94.5				
Missouri Limestone	no show	4.72.7	5.00.5			
Madison sand	no show	5.00.5	5.11.2			
Wipac Limestone	no show	5.12.2	5.24.5			
Simpson	no show	5.24.5	5.38.4			
Celicious Limestone	no show	5.38.4	5.40.5			

Describe in detail the manner in which the well was plugged, indicating where the mud fluid was placed and the method or methods used in introducing it into the hole. If cement or other plugs were used, state the character of same and depth placed, from 2.20 to 2.30 feet to feet for each plug set.

Cement Plug placed at 2.20 to 2.30 ft - mud in
Cement Plug up to within 12 ft of top & a
12 ft cement plug in top of 10 1/2 casing & then
milled flat over casing.

FILED 18-34-1310
BICK 1058114-43

(If additional description is necessary use BACK of this sheet)

Correspondence regarding this well should be addressed to Helmerich & Payne
Address 1702 Phillmore Bldg. Tulsa Okla

STATE OF Kansas, COUNTY OF Barber, ss.

(employee of owner) or (owner or operator) of the above-described well,
being first duly sworn on oath, says: That I have knowledge of the facts, statements, and matters herein contained and the log of the above-described
well as filed and that the same are true and correct. So help me God.

(Signature) A. R. Colman

SUBSCRIBED AND SWORN TO before me this 1st day of November, 1937 (Address)

My commission expires May 5, 1941 G. W. Richardson Notary Public