

STATE OF KANSAS
STATE CORPORATION COMMISSION


WELL PLUGGING RECORD

Give All Information Completely
Make Required Affidavit
Mail or Deliver Report to:
Conservation Division
State Corporation Commission
800 Biting Building
Wichita, Kansas

Sumner County, Sec. 11 Twp. 30 Rge. 1 (W) (W)

Location as "NE/CNW $\frac{1}{4}$ SW $\frac{1}{4}$ " or footage from lines SE SE SE
Lease Owner Sterling Drilling Company
Lease Name Long Well No. 1
Office Address Sterling, Kansas
Character of Well (completed as Oil, Gas or Dry Hole) Dry Hole
Date well completed February 27 19 50
Application for plugging filed February 28 19 50
Application for plugging approved February 28 19
Plugging commenced February 28 19 50
Plugging completed February 28 19 50
Reason for abandonment of well or producing formation Dry Hole

NORTH

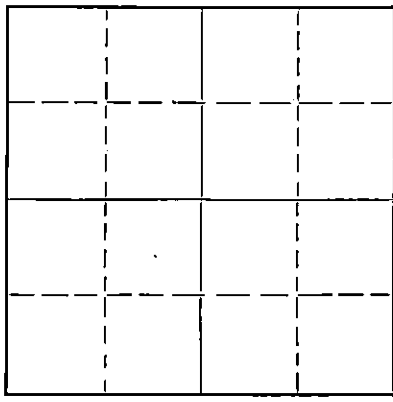

Locate well correctly on above Section Flat

If a producing well is abandoned, date of last production 19
Was permission obtained from the Conservation Division or its agents before plugging was commenced? Yes

Name of Conservation Agent who supervised plugging of this well W. G. Buffington
Producing formation Depth to top Bottom Total Depth of Well 3895 Feet
Show depth and thickness of all water, oil and gas formations.

OIL, GAS OR WATER RECORDS

CASING RECORD

Formation	Content	From	To	Size	Put In	Pulled Out
				8-5/8"	280'	
				5 1/2"	3851'	

Describe in detail the manner in which the well was plugged, indicating where the mud fluid was placed and the method or methods used in introducing it into the hole. If cement or other plugs were used, state the character of same and depth placed, from feet to feet for each plug set.

Fill with rock to 3845'. Run 5 sacks cement. After pulling pipe fill with heavy mud. Run 15 sacks cement at 280'. Fill with mud to within 35' of surface. Run 10 sacks cement.

(If additional description is necessary, use BACK of this sheet)

Correspondence regarding this well should be addressed to Sterling Drilling Company
Address Sterling, Kansas

STATE OF Kansas, COUNTY OF Rice, ss.
Rollin Mead (employee of owner) or (owner or operator) of the above-described well,

being first duly sworn on oath, says: That I have knowledge of the facts, statements, and matters herein contained and the log of the above-described well as filed and that the same are true and correct. So help me God.

(Signature) Rollin Mead
Sterling, Kansas (Address)

SUBSCRIBED AND SWORN TO before me this 28th day of February 19 50

My commission expires Aug. 17, 1953 Notary Public.

My Commission Expires Aug. 17, 1953

22-7877-8 4-49-10M

PLUGGING
FILE SEC 11 T 30 R 10
BOOK PAGE 149 LINE 31

STERLING DRILLING CO.

STERLING, KANSAS

WELL LOG ----- LONG NO. 1

Location - SE/4 SE/4 SE/4 of Section 11-30-1W, Sumner County, Kansas.

Owner - Sterling Drilling Company
Contractor - Sterling Drilling Company

Commenced - 2-3-50
Completed - 2-19-50

Total Depth - 3853' (w/r)

ELEVATION: 1233 DF
1231 Gr

LOG

0- 205	Sand, Surface Clay, Shale
205- 750	Shale and Shells
750-1900	Shale and Lime
1900-2060	Broken Lime
2060-2490	Shale and Lime
2490-2610	Shale
2610-3020	Lime
3020-3402	Lime and Shale
3402-3420	Mississippi Lime
3420-3425	Conglomerate Chert
3425-3645	Lime
3645-3675	Lime and Chert
3675-3755	Lime
3755-3851	Shale
3851-3853	Sand

CASING RECORD

280 Feet 8-5/8" Surface Pipe
Cemented with 200 Sacks Cement

3867 Feet 5 1/2" O.D. Casing
Cemented with 50 Sacks Cement

PRODUCTION - Dry and Abandoned

PLUGGING
 FILE SEC 11 T 30 R 1 W
 BOOK PAGE 40 LINE 31

ENGINEERING
 MAR 2 X 1950
 S. J. ...
 ...