


STATE OF KANSAS
STATE CORPORATION COMMISSION
Get All Information Completely
Make Required Affidavit
Mail or Deliver Report to:
Conservation Division
State Corporation Commission
800 Biting Building
Wichita, Kansas

WELL PLUGGING RECORD

Sumner County. Sec. 22 Twp. 34 Rge. 3 (W)

Location as "NE/CNW/SW" or footage from lines NW SE SW
Lease Owner Herndon Drilling Company
Lease Name A. Subera Well No. 1-A
Office Address Tulsa, Oklahoma
Character of Well (completed as Oil, Gas or Dry Hole) Dry Hole
Date well completed 3/23/56 19
Application for plugging filed 3/23/56 19
Application for plugging approved 3/23/56 19
Plugging commenced 3/23/56 19
Plugging completed 3/23/56 19
Reason for abandonment of well or producing formation _____

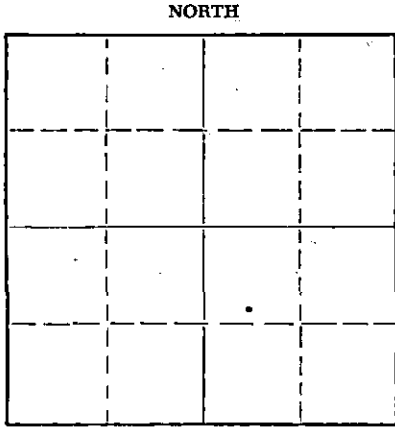

Locate well correctly on above Section Plat

If a producing well is abandoned, date of last production _____ 19
Was permission obtained from the Conservation Division or its agents before plugging was commenced? Yes

Name of Conservation Agent who supervised plugging of this well W. G. Buffington, Gueda Springs, Kansas
Producing formation _____ Depth to top _____ Bottom _____ Total Depth of Well 4813 Feet
Show depth and thickness of all water, oil and gas formations.

OIL, GAS OR WATER RECORDS

CASING RECORD

FORMATION	CONTENT	FROM	TO	SIZE	PUT IN	PULLED OUT
				<u>8 5/8</u>	<u>656</u>	

Describe in detail the manner in which the well was plugged, indicating where the mud fluid was placed and the method or methods used in introducing it into the hole. If cement or other plugs were used, state the character of same and depth placed, from 630 feet to 40 feet for each plug set.

Hole was filled to 630 feet with rotary mud, plug spotted and 15 sacks cement was mixed and poured thru drill pipe. Hole was filled to 40 feet, plug set and ten sacks cement mixed and poured in hole. Steel cap was welded on casing.

STATE CORP
3-30-56
CONSERVATION DIVISION
WICHITA, KANSAS

(If additional description is necessary, use BACK of this sheet)


Name of Plugging Contractor Herndon Drilling Company
Address Drawer 489 - Tulsa, Oklahoma

STATE OF Oklahoma, COUNTY OF Tulsa, ss.
Tom Elliott (employee of owner) or (conservation operator) of the above-described well, being first duly sworn on oath, says: That I have knowledge of the facts, statements, and matters herein contained and the log of the above-described well as filed and that the same are true and correct. So help me God.

(Signature) Tom Elliott
Drawer 489 - Tulsa, Oklahoma
(Address)

SUBSCRIBED AND SWORN to before me this 27th day of March, 1956

My commission expires 4/22/57
Patsy M. Mearns Notary Public.

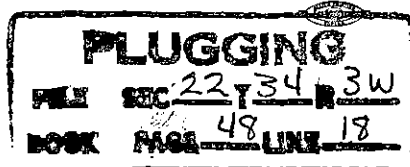

15-191-00342-0000

WELL LOG ON A. SUBERA #1-A

Spudding date: 3/4/56
Date casing set: 3/5/56
Date rotary completed: 3/23/56
Date cable completed:

Location:
Sec. 22-34S-3W - Sumner Co., Kansas

<u>FROM</u>	<u>TO</u>	<u>FORMATION</u>	<u>REMARKS</u>
0	665	Surface Hole	Ran 21 Jts. 8-5/8" 24# Casing @ 656' Cemented w/ 475 Sx. w/ 10 Sx. CC
665	1730	Lime & Shale	
1730	1900	Shale	
1900	3520	Lime & Shale	
3520	3642	Sand & Shale	
3642	4355	Shale & Lime	
4355	4665	Lime	
4665	4705	Lime & Shale	
4705	4810	Lime	
4810	4813	Sand	
4813		Total Depth	

Plugged hole w/ 15 Sx. Cement @ 630'
and 10 Sx. Cement @ 40'.

RECEIVED
STATE COMMISSION
MARCH 30 1956
CONSERVATION DIVISION
WELL LOG, Kansas

Subscribed and sworn to before me this 28th
day of March 19 56

I certify the above and foregoing to be a true and exact
copy of the original driller's log on the A. SUBERA #1-A

HERNDON DRILLING COMPANY

Walter M. Murray
Notary Public
My commission expires: 4/22/57

By: C. J. Moore
Title: Assistant Secretary

PLUGGING
SEC 22-34-3W
BOX 48 LINE 18