


STATE OF KANSAS
STATE CORPORATION COMMISSION

Give All Information Completely
Make Required Affidavit
Mail or Deliver Report to:
Conservation Division
State Corporation Commission
212 North Market, Insurance Bldg.
Wichita, Kansas

WELL PLUGGING RECORD

NORTH

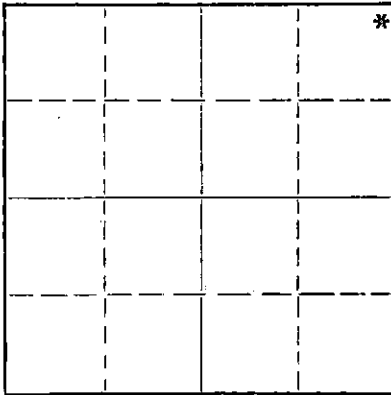

Locate well correctly on above
Section Plat

Sumner

County. Sec. 17 Twp. 34S Rge. 1 (E) W (W)

Location as "NE/CNW/SW" or footage from lines NE NE NE

Lease Owner Robinowitz Oil Company

Lease Name Norton

Well No.

Office Address 311 Shell Building, Tulsa 19, Oklahoma

Character of Well (completed as Oil, Gas or Dry Hole) Dry Hole

Date well completed 4-13 19 60

Application for plugging filed 4-13 19 60

Application for plugging approved 4-13 19 60

Plugging commenced 4-13 19 60

Plugging completed 4-13 19 60

Reason for abandonment of well or producing formation Dry Hole

If a producing well is abandoned, date of last production 19

Was permission obtained from the Conservation Division or its agents before plugging was commenced? Yes

Name of Conservation Agent who supervised plugging of this well Lee Guthrie

Producing formation Depth to top Bottom Total Depth of Well Feet

Show depth and thickness of all water, oil and gas formations.

OIL, GAS OR WATER RECORDS

CASING RECORD

FORMATION	CONTENT	FROM	TO	SIZE	PUT IN	PULLED OUT
Surface Pipe		-0-	282	8 5/8	282	-0-

Describe in detail the manner in which the well was plugged, indicating where the mud fluid was placed and the method or methods used in introducing it into the hole. If cement or other plugs were used, state the character of same and depth placed, from feet to feet for each plug set.

Filled hole w/heavy mud to 260'.

Set plug w/ 1/3 sack hulls and 15 sacks cement through Drill Pipe.

Filled hole to 35'. Set plug with 1/4 sack hulls & 10 sacks cement.

Plugged rat hole with 2 sacks cement.

RECEIVED
STATE CORPORATION COMMISSION

APR 22 1960

CONSERVATION DIVISION
Wichita, Kansas

(If additional description is necessary, use BACK of this sheet)
Name of Plugging Contractor C. L. Miles d/b/a A. L. Jackson Drilling Company
Address P. O. Box 194, Great Bend, Kansas

STATE OF KANSAS, COUNTY OF BARTON, ss.
C. L. Miles, contractor on

(employee of owner) or (owner or operator) of the above-described well, being first duly sworn on oath, says: That I have knowledge of the facts, statements, and matters herein contained and the log of the above-described well as filed and that the same are true and correct. So help me God.

(Signature)

Box 194 Great Bend, Kansas
(Address)

SUBSCRIBED AND SWORN to before me this 14th day of April, 19 60

Jean Kimber

Notary Public.

My commission expires 12-3-63

INVOICED

DATE 4-22-60

INV. NO. 1271-E

W E L L L O G
 Norton # 1
 NE NE NE 17-34S-1W
 Sumner County, Kansas

0 - 65	Surface clay, post rock	Elevation	1155'D.F.
65 - 80	Sand		
80 - 280	Shale and shells	Formation Tops:	
280 - 420	Shale and shells		
420 - 700	Shale	Stalnaker	2915'
700 - 935	Shale	Layton	3345'
935 - 1105	Lime and shale	Kansas City	3414'
1105 - 1260	Lime streaks & shale	Mississippi chat	4061'
1260 - 2255	Shale	Mississippi lime	4090'
2255 - 2365	Shale and lime	Kinderhook shale	4430'
2365 - 2460	Shale	Chattanooga shale	4480'
2460 - 2615	Lime and shale	Simpson	4500'
2615 - 2655	Shale	Total Depth	4535'
2655 - 2835	Lime and shale		
2835 - 2950	Shale		
2950 - 3050	Lime and shale		
3050 - 3140	Sandy lime - pyrite and shale		
3140 - 3350	Shale		
3350 - 3700	Shale and lime		
3700 - 3735	Shale and lime - Big lime		
3735 - 3810	Big lime		
3810 - 3873	Lime and shale		
3873 - 4061	Shale		
4061 - 4078	Mississippi chat		
4078 - 4093	Chat and lime		
4093 - 4148	Mississippi shale		
4148 - 4188	Mississippi		
4188 - 4203	Lime, cherty		
4203 - 4243	Mississippi		
4243 - 4266	Lime - shale		
4266 - 4289	Lime - iron		
4289 - 4295	Mississippi		
4295 - 4299	Lime and chat		
4299 - 4332	Lime		
4332 - 4359	Lime pyrite		
4359 - 4416	Mississippi		
4416 - 4429	Shale and lime		
4429 - 4470	Shale - kinderhook		
4470 - 4506	Kinderhook		
4506 - 4520	Shale and lime		
4520 - 4535	Lime		
4535	Total Depth		

RECEIVED
 STATE CORPORATION COMMISSION
 APR 22 1960
 CONSERVATION DIVISION

STATE OF KANSAS
 COUNTY OF BARTON ss

C. L. Miles, d/b/a A. L. Jackson Drilling Company, being first duly sworn on oath says: That I have knowledge of the facts, statements and matters herein contained and the log of the above described well as filed and that the same are true and correct.

C. L. Miles
 C. L. Miles

Subscribed and sworn before me this 14th day of April, 1960.

Jean Kimber
 Notary Public Barton County

My Commission Expires: December 3, 1963.