


STATE OF KANSAS  
STATE CORPORATION COMMISSION  
Give All Information Completely  
Make Required Affidavit  
Mail or Deliver Report to:  
Conservation Division  
State Corporation Commission  
211 No. Broadway  
Wichita, Kansas

### WELL PLUGGING RECORD

Stevens County. Sec. 10 Twp. 34S Rge.      (E) 35 (W)  
Location as "NE/CNW/SW" or footage from lines. G NE SW  
Lease Owner Cities Service Petroleum Company  
Lease Name Skinner "B" Well No. 2  
Office Address Box 1147, Liberal, Kansas  
Character of Well (completed as Oil, Gas or Dry Hole) Dry Hole  
Date well completed 1-13- 1962  
Application for plugging filed 1-15- 1962  
Application for plugging approved      19      
Plugging commenced 1-14- 1962  
Plugging completed 1-14- 1962  
Reason for abandonment of well or producing formation Dry Hole

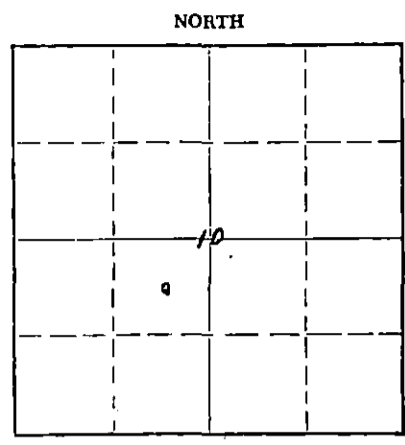

Locate well correctly on above Section Plat

If a producing well is abandoned, date of last production      19      
Was permission obtained from the Conservation Division or its agents before plugging was commenced? Yes

Name of Conservation Agent who supervised plugging of this well Mr. W. L. Lackamp, Jr.  
Producing formation      Depth to top      Bottom      Total Depth of Well      Feet  
Show depth and thickness of all water, oil and gas formations.

OIL, GAS OR WATER RECORDS				CASING RECORD		
FORMATION	CONTENT	FROM	TO	SIZE	PUT IN	PULLED OUT
D.S.T.-Marmaton	420' M.S.W.	5173	5190	8-5/8 OD	2887	None

Describe in detail the manner in which the well was plugged, indicating where the mud fluid was placed and the method or methods used in introducing it into the hole. If cement or other plugs were used, state the character of same and depth placed, from      feet to      feet for each plug set.

- 6595' to 2880' - Heavy Mud
- 2880' to 2633' - Spotted 75 sx. Common Cement
- 2633' to 650' - Heavy Mud
- 650' to 584' - Spotted 20 sx. Common Cement
- 584' to 35' - Heavy Mud
- 35' to Surface - Spotted 10 sx. Cement

**RECEIVED**  
STATE CORPORATION COMMISSION  
JAN 25 1962  
CONSERVATION DIVISION  
Wichita, Kansas

(If additional description is necessary, use BACK of this sheet)

Name of Plugging Contractor Halliburton Company  
Address Duncan, Oklahoma

STATE OF Kansas, COUNTY OF Seward, ss.  
I, W. J. Devaney (employee of owner) or (~~owner or operator~~) of the above-described well, being first duly sworn on oath, says: That I have knowledge of the facts, statements, and matters herein contained and the log of the above-described well as filed and that the same are true and correct. So help me God.

(Signature) W. J. Devaney  
Box 1147, Liberal, Kansas  
(Address)

SUBSCRIBED AND SWORN TO before me this 15th day of January, 19 62  
James F. Kyger James F. Kyger  
Notary Public.

My commission expires 3-31-65

