

COPY

CONFIDENTIAL

SIDE ONE

STATE CORPORATION COMMISSION OF KANSAS
 OIL & GAS CONSERVATION DIVISION
 WELL COMPLETION FORM
 ACO-1 WELL HISTORY
 DESCRIPTION OF WELL AND LEASE

Operator: License # 04782

Name: Ensign Operating Co.

Address 621 17th St., Suite 1800

City/State/Zip Denver, Colorado 80293

Purchaser: Petro Source

Operator Contact Person: J. C. Simmons

Phone (303) 293-9999

Contractor: Name: Brandt Drilling Co., Inc.

License: _____

Wellsite Geologist: Duane E. Mordock

Designate Type of Completion

New Well Re-Entry Workover

Oil SWD Temp. Abd.
 Gas Inj Delayed Comp.
 Dry Other (Core, Water Supply, etc.)

If OWMO: old well info as follows:

Operator: _____

Well Name: _____

Comp. Date _____ Old Total Depth _____

Drilling Method:

Mud Rotary Air Rotary Cable

1/15/91 2/2/91 3/15/91

Spud Date Date Reached TD Completion Date

API No. 15- 119-20,824-00-00
County Meade

SW NE Sec. 17 Twp. 34S Rge. 28 East West

3200' Ft. North from Southeast Corner of Section

1980' Ft. West from Southeast Corner of Section
(NOTE: Locate well in section plat below.)


Lease Name Ross Well # 3-17

Field Name Unnamed

Producing Formation Marmaton

Elevation: Ground 2432' KB 2438'

Total Depth 6500' PBSD 5289'

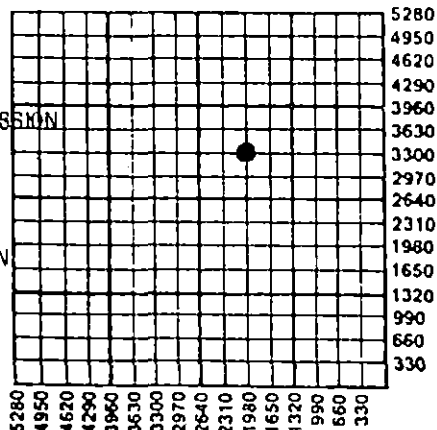

RECEIVED
STATE CORPORATION COMMISSION

MAY 8 1991

CONSERVATION DIVISION
Wichita, Kansas

Amount of Surface Pipe Set and Cemented at 1628' Feet:

Multiple Stage Cementing Collar Used? Yes No

If yes, show depth set _____ Feet

If Alternate II completion, cement circulated from _____

feet depth to _____ w/ _____ sx cnt.

INSTRUCTIONS: This form shall be completed in triplicate and filed with the Kansas Corporation Commission, 200 Colorado Derby Building, Wichita, Kansas 67202, within 120 days of the spud date of any well. Rule 82-3-130, 82-3-107 and 82-3-106 apply. Information on side two of this form will be held confidential for a period of 12 months if requested in writing and submitted with the form. See rule 82-3-107 for confidentiality in excess of 12 months. One copy of all wireline logs and drillers time log shall be attached with this form. ALL CEMENTING TICKETS MUST BE ATTACHED. Submit CP-111 form with all plugged wells. Submit CP-111 form with all temporarily abandoned wells. Any recompletion, workover or conversion of a well requires filing of ACO-2 within 120 days from commencement date of such work.

All requirements of the statutes, rules and regulations promulgated to regulate the oil and gas industry have been fully complied with and the statements herein are complete and correct to the best of my knowledge.

Signature Conni Smith

Title Sr. Engineering Technician

Subscribed and sworn to before me this 16
19 1991.

Notary Public _____

Date Commission Expires _____

| | | |
|--|-------------------------------------|------------------------------------|
| <input checked="" type="checkbox"/> K.C.C. OFFICE USE ONLY | | |
| F | <input type="checkbox"/> | Letter of Confidentiality Attached |
| C | <input checked="" type="checkbox"/> | Wireline Log Received |
| C | <input type="checkbox"/> | Drillers Timelog Received |
| Distribution | | |
| <input checked="" type="checkbox"/> | KCC | <input type="checkbox"/> SWD/Rep |
| <input type="checkbox"/> | KGS | <input type="checkbox"/> Plug |
| | | <input type="checkbox"/> NGPA |
| | | <input type="checkbox"/> Other |
| | | (Specify) |