


STATE OF KANSAS  
STATE CORPORATION COMMISSION

WELL PLUGGING RECORD

Give All Information Completely  
Make Required Affidavit  
Mail or Deliver Report to  
Conservation Division  
State Corporation Comm.  
245 North Water  
Wichita, KS 67202

Stevens County. Sec. 9 Twp. 34S Rge. 35 E/W  
Location as "NE/CNW $\frac{1}{4}$ SW $\frac{1}{4}$ " or footage from lines 30

NW NW SE  
Lease Owner Mohawk Energy Corporation  
Lease Name Skinner Well No. 1  
Office Address 2401 Fourth Nat'l, Bank Bldg., Tulsa, Okla. 74119  
Character of Well (Completed as Oil, Gas or Dry Hole) \_\_\_\_\_

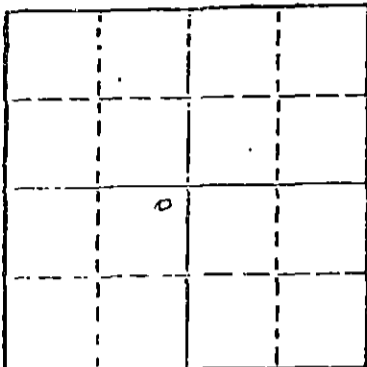

Locate well correctly on above  
Section Plot

Dry Hole  
Date Well completed 10-16-79 19  
Application for plugging filed 10-16-79 19  
Application for plugging approved \_\_\_\_\_ 19  
Plugging commenced 10-16-79 19  
Plugging completed 10-16-79 19  
Reason for abandonment of well or producing formation \_\_\_\_\_

D & A  
If a producing well is abandoned, date of last production \_\_\_\_\_ 19

Was permission obtained from the Conservation Division or its agents before plugging was commenced? Yes

Name of Conservation Agent who supervised plugging of this well Gilbert Balthazor  
Producing formation None Depth to top \_\_\_\_\_ Bottom \_\_\_\_\_ Total Depth of Well 6650  
Show depth and thickness of all water, oil and gas formations.

OIL, GAS OR WATER RECORDS

CASING RECORD

FORMATION	CONTENT	FROM	TO	SIZE	PUT IN	PULLED OUT
				8 5/8	1754	None

Describe in detail the manner in which the well was plugged, indicating where the mud fluid was placed and the method or methods used in introducing it into the hold. If cement or other plugs were used, state the character of same and depth placed, from \_\_\_\_\_ feet to \_\_\_\_\_ feet for each plug set.

Halliburton Spotted 50 sacks cement through drill pipe  
at 1700'. Spotted 10 sacks from 40' to top.

(If additional description is necessary, use BACK of this sheet)

Name of Plugging Contractor \_\_\_\_\_

STATE OF Oklahoma COUNTY OF Tulsa, ss.  
Ruth McBryar, Ass't. Sec'y. (employee of owner) or (owner or operator)  
of the above-described well, being first duly sworn on oath, says: That I have knowledge of the facts, statements, and matters herein contained and the log of the above-described well as filed and that the same are true and correct. So help me God.

(Signature) Ruth McBryar  
Tulsa, Oklahoma

SUBSCRIBED AND SWORN TO before me this 26th day of October 1979

Kathryn L. Calvert  
Notary Public.  
Conservation Division  
Wichita, Kansas

My commission expires 2-27-82

GABBERT-JONES, INC.  
WICHITA, KANSAS  
DRILLERS' WELL LOG

Skinner #1  
NW NW SE Sec 9-34S-35W  
Stevens County Kansas

Commenced: 10-1-79

Completed: 10-16-79

OPERATOR: Mohawk Energy Corp.

From	Dept to	Formation	Remarks
0	500	Surface Clay-Sand	Ran 44 jts of 23# 8 5/8" csg
500	1240	Redbed-Sand-Shale	set @ 1754' Cemented w/
1240	1554	Redbed-Shale	750 sks L.W. 2% CC +
1554	1754	Redbed-Anhy	150 sks Common 3% CC
1754	1900	Anhy-Redbed	PD @ 10:00 a.m. 10-3-79
1900	2375	Shale-Anhy	1" w/85 sks Common
2375	2444	Shale-Lime	Job Completed @ 12:30 p.m. 10-3-79
2444	6650	Lime-Shale	
	6650 - TD		DRY & ABANDONED

STATE OF KANSAS )  
                          ) SS.  
COUNTY OF SEDGWICK)

I, the undersigned, being duly sworn on oath, state that the above Drillers' Well Log is true and correct to the best of my knowledge and belief and according to the records of this office.

GABBERT-JONES, INC.

*James S. Sutton II*  
JAMES S. SUTTON II

Subscribed and sworn to before me this 22nd day of October, 1979.

*Elizabeth J. Edwards*  
ELIZABETH J. EDWARDS-NOTARY PUBLIC

My Commission expires February 6, 1983.

