


15-119-00079-0000

STATE OF KANSAS  
STATE CORPORATION COMMISSION

Give All Information Completely  
Make Required Affidavit  
Mail or Deliver Report to:  
Conservation Division  
State Corporation Commission  
211 No. Broadway  
Wichita, Kansas

WELL PLUGGING RECORD

NORTH

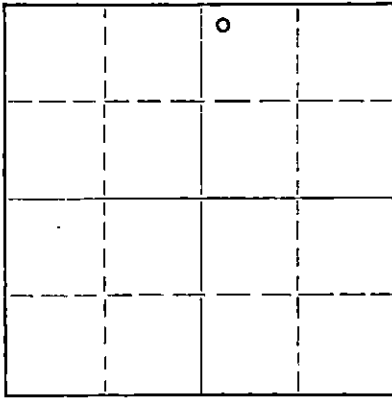

Locate well correctly on above  
Section Plat

Meade County, Sec. 2 Twp. 34S Rge. 29 (W)  
Location as "NE/CNW/SW" or footage from lines 330' fr North and 2,310' fr. E  
Lease Owner The Shamrock Oil and Gas Corporation  
Lease Name Ernest Cordes Well No. 1  
Office Address Box 631, Amarillo, Texas  
Character of Well (completed as Oil, Gas or Dry Hole) Dry Hole  
Date well completed 9-30 19 58  
Application for plugging filed 9-30 19 58  
Application for plugging approved 10-15 19 58  
Plugging commenced 10-28 19 58  
Plugging completed 11-1 19 58  
Reason for abandonment of well or producing formation Dry

If a producing well is abandoned, date of last production 19  
Was permission obtained from the Conservation Division or its agents before plugging was commenced? Yes

Name of Conservation Agent who supervised plugging of this well Merle Rives  
Producing formation None Depth to top Bottom Total Depth of Well 5910 Feet  
Show depth and thickness of all water, oil and gas formations.

OIL, GAS OR WATER RECORDS

CASING RECORD

FORMATION	CONTENT	FROM	TO	SIZE	PUT IN	PULLED OUT
Shale & sand	Water	0	585	9 5/8"	1544'	-0-
				5 1/2"	5910	3226.95'

Describe in detail the manner in which the well was plugged, indicating where the mud fluid was placed and the method or methods used in introducing it into the hole. If cement or other plugs were used, state the character of same and depth placed, from feet to feet for each plug set.  
Dumped sand from 4,856' to 4,780'. Dumped 5 sacks cement from 4,780' to 4,740'. Shot casing at 4,011'; 3,816'; 3,601'; 3,415'; 3,330'; and 3,221'. Worked pipe loose at 3,221'. Mixed 20 sacks mud. Circulated at 1,850'. Bailed hole to 550'. Bridged hole at 550' with rocks and sacks. Dumped 20 sacks of cement at 550' and let set 4 hours. Filled hole with heavy mud. Dumped 10 sacks cement in top of casing.

(If additional description is necessary, use BACK of this sheet)  
Name of Plugging Contractor Forbes Well Pulling Unit  
Address Great Bend, Kansas

STATE OF TEXAS, COUNTY OF POTTER, ss.  
T. S. Clopton (employee of owner) or (owner) of the above-described well, being first duly sworn on oath, says: That I have knowledge of the facts, statements, and matters herein contained and the log of the above-described well as filed and that the same are true and correct. So help me God.

(Signature) T. S. Clopton  
Box 631, Amarillo, Texas (Address)

SUBSCRIBED AND SWORN TO before me this 6th day of November 19 58  
My commission expires 6-1-59  
Notary Public: PAULINE POWELL, STATE CORPORATION COMMISSION, Potter County, Texas

PLUGGING  
FILE SEC 2 T. 34 R. 29W  
BOOK PAGE 136 LINE 31

NOV 10 1958  
CONSERVATION DIVISION  
Wichita, Kansas

Shamrock Oil & Gas 15-119-00079-0000  
 D+M Drilling

ERNEST CORDES NO. 1  
 Section 2, T34S, R29W, Meade County,  
 Kansas

NW NW NE  
 Drilling

0' - 75'	Sand
75' - 535'	Shale, sand, & shells
535' - 585'	Sand & shale
585' - 765'	Red bed & shells
765' - 1,100'	Sand, shale, & shells
1,100' - 1,893'	Shale & shells
1,893' - 2,045'	Shale, lime, & shells
2,045' - 4,027'	Shale & lime
4,027' - 4,193'	Shale & lime streaks
4,193' - 4,215'	Lime
4,215' - 4,442'	Shale & lime
4,442' - 4,474'	Lime w/ shale streaks
4,474' - 4,799'	Lime
4,799' - 4,812'	Shale
4,812' - 4,848'	Lime & shale
4,848' - 5,317'	Lime
5,317' - 5,343'	Lime & shale
5,343' - 5,462'	Lime
5,462' - 5,619'	Lime & shale
5,619' - 5,683'	Lime w/ shale streaks
5,683' - 5,918'	Lime

*(Faint mirrored text from reverse side of page)*

PLUGGING  
 FILE SEC 2 T34 R29W  
 BOOK PAGE 136 LINE 31

RECEIVED  
 STATE CORPORATION COMMISSION  
 OCT 15 1958  
 CONSERVATION DIVISION  
 Wichita, Kansas