


Give All Information Completely
Make Required Affidavit
Mail or Deliver Report to:
Conservation Division
State Corporation Commission
211 No. Broadway
Wichita, Kansas

WELL PLUGGING RECORD

Meade County, Sec. 2 Twp. 34S Rge. (E) 29 (W)
Location as "NE/CNW/SW" or footage from lines NW/4 NW/4 NW/4
Lease Owner Skelly Oil Company
Lease Name P. O. Mohler Well No. 2
Office Address P.O. Box 1650, Tulsa, Oklahoma
Character of Well (completed as Oil, Gas or Dry Hole) Gas
Date well completed September 6, 19 58
Application for plugging filed October 8, 19 65
Application for plugging approved October 11, 19 65
Plugging commenced November 22, 19 65
Plugging completed November 24, 19 65
Reason for abandonment of well or producing formation Depleted

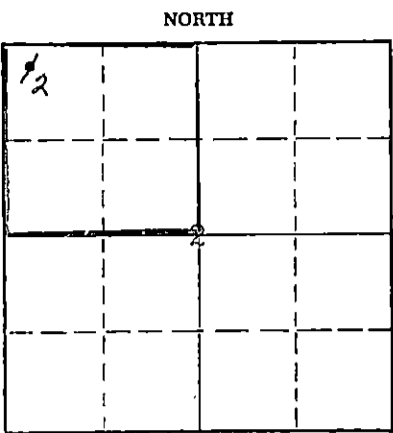

Locate well correctly on above Section Plat

If a producing well is abandoned, date of last production Shut Down 8/1 19 63
Was permission obtained from the Conservation Division or its agents before plugging was commenced? Yes

Name of Conservation Agent who supervised plugging of this well Mr. Hugh Scott
Producing formation Morrow Sand Depth to top 5712' Bottom Total Depth of Well 5880 Feet
Show depth and thickness of all water, oil and gas formations. PB 5795'

OIL, GAS OR WATER RECORDS

CASING RECORD

FORMATION	CONTENT	FROM	TO	SIZE OD	PUT IN	PULLED OUT
Morrow Sand	Gas	5712'	5720'	8-5/8"	1438'	None
				5-1/2"	5927'6"	4736'

Describe in detail the manner in which the well was plugged, indicating where the mud fluid was placed and the method or methods used in introducing it into the hole. If cement or other plugs were used, state the character of same and depth placed, from feet to feet for each plug set.

30 sacks of cement 5795' to 4780'
Mud laden fluid 4780' to 700'
Hull bridge 700' to 690'
35 sacks of cement 690' to 590'
Mud laden fluid 590' to 55'
Hull bridge 55' to 45'
15 sacks of cement 45' to Base of cellar
Surface soil Cellar to Surface

RECEIVED
STATE CORPORATION COMMISSION

JAN 6 1966

CONSERVATION DIVISION
Wichita, Kansas

(If additional description is necessary, use BACK of this sheet)
Name of Plugging Contractor Sargent's Casing Pulling Service
Address 121 West 9th St., Liberal, Kansas

STATE OF Nebraska, COUNTY OF Red Willow, ss.
C. F. Bass (employee of owner) or (owner/operator) of the above-described well, being first duly sworn on oath, says: That I have knowledge of the facts, statements, and matters herein contained and the log of the above-described well as filed and that the same are true and correct. So help me God.


(Signature) C. F. Bass
P. O. Box 649, McCook, Nebraska 69001
(Address)

SUBSCRIBED AND SWORN TO before me this 4th day of January 19 66

My commission expires June 13, 1969

C. E. Lindsey
Notary Public.

SKELLY OIL COMPANY

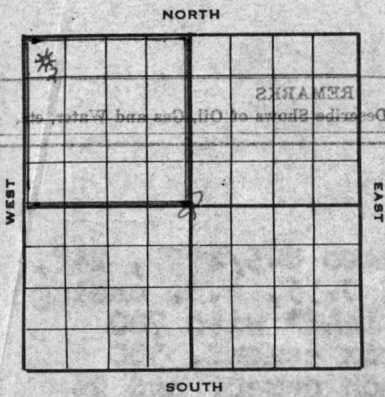

Well Record

Lease Name and No. P. O. Mohler Well No. 2 Elev. 2470'

Lease Description S/2 Sec. 35, and N/2 SE/4 Sec. 34-33S-29W, and NW/4 Section 2-34S-29W, Meade County, Kans. (560 A)

Location made July 15, 19 58 by W. C. Wilson

330 feet from North line 330 feet from East line NW/4

330 feet from South line 330 feet from West line of Sec. 2

Work com'd 7/16 19 58 Rig comp'd 7/16 19 58 Drlg. com'd 7/18 19 58 Drlg. comp'd 8/20 19 58

Rig Contractor Claude Wentworth Drilling Co., Inc.

Drilling Contractor Claude Wentworth Drilling Co., Inc., Tulsa, Oklahoma

Rotary Drilling from 0' to 5880' Cable Tool Drilling from To complete to

Completed 9/6/58

Commenced Producing SI for pipeline connection 19

Initial Prod. before shot or acid Bbls.

Initial Prod. after shot or acid Bbls.

Dry Gas Well Press. Volume 3,210,000 Cu. ft.

Casing Head Gas Pressure Volume Cu. ft.

Braden Head (8-5/8" 51" OD) Gas Pressure Volume Cu. ft.

Braden Head () Gas Pressure Volume Cu. ft.

PRODUCING FORMATION Morrow Sand (Name) Top 5712' Bottom 5720' TOTAL DEPTH 5880' 5795'

CASING RECORD

OD	Size	Wt.	Thds.	Where Set	PULLED OUT			LEFT IN			KIND	Cond'n	CEMENTING	
					Jts.	Feet	In.	Jts.	Feet	In.			Sacks Used	Method Employed
8-5/8"	24#	8R	1448'				8	1438	0	J55 R2 S3 A		1000	Halliburton	
5-1/2"	15#	8R					61	1910	0	J55 R2 S3 A				
5-1/2"	14#	8R					97	3019	1	J55 R2 S3 A				
5-1/2"	15#	8R	5880'				31	998	5	J55 R2 S3 A		200	Halliburton	
(8-5/8" casing set 2' in cellar and 5 1/2" cased to derrick floor)														
5 1/2" casing perforations open:														
Above PB ID: 5712'-5720' with 32 holes														
Below PB ID: None														

Liner Set at Length Perforated at

Liner Set at Length Perforated at

Packer Set at Size and Kind

Packer Set at Size and Kind

SHOT OR ACID TREATMENT RECORD

	FIRST	SECOND	THIRD	FOURTH
Date	<u>8/25/58</u>	<u>8/26/58</u>	<u>8/27/58</u>	
Acid Used	<u>500</u> Gals.	<u></u> Gals.	<u>500</u> Gals.	<u></u> Gals.
Size Shot	<u>500</u> Qts.	<u></u> Qts.	<u>500</u> Qts.	<u></u> Qts.
Shot Between	<u>5712</u> Ft. and <u>5720</u> Ft.	<u>5712</u> Ft. and <u>5720</u> Ft.	<u>5236</u> Ft. and <u>5240</u> Ft.	<u></u> Ft. and <u></u> Ft.
Size of Shell				
Put in by (Co.)	<u>Halliburton</u>	<u>Halliburton</u>	<u>Halliburton</u>	
Length anchor		<u>(Vis-O-Frac)</u>		
Distance below Cas'g				
Damage to Casing or Casing Shoulder				

SIGNIFICANT GEOLOGICAL FORMATIONS

NAME	Top	Bottom	GAS		OIL		REMARKS
			From	To	From	To	
<u>Heebner Shale</u>	<u>4363'</u>						<p style="text-align: center;">RECEIVED</p> <p style="text-align: center;">STATE CORPORATION COMMISSION</p> <p style="text-align: center;">JAN 6 1966</p> <p style="text-align: center;">CONSERVATION DIVISION</p> <p style="text-align: center;">Wichita, Kansas</p>
<u>Lansing Lime</u>	<u>4513'</u>						
<u>Narmaton Lime</u>	<u>5157'</u>						
<u>Cherokee Lime</u>	<u>5373'</u>						
<u>Morrow Shale</u>	<u>5684'</u>						
<u>Morrow Sand</u>	<u>5712'</u>	<u>5712'</u>	<u>5720'</u>				
<u>Chester</u>	<u>5780'</u>						

CLEANING OUT RECORDS

	DATE COMMENCED	DATE COMPLETED	PROD. BEFORE	PROD. AFTER	REMARKS
1st					See Reverse for other details.
2nd					" " " " "
3rd					" " " " "
4th					" " " " "

PLUGGING BACK AND DEEPENING RECORDS

	Date Commenced	Date Completed	No. Feet Plugged Back or Deepened	Prod. Before	Prod. After	REMARKS
1st						See Reverse for other details.
2nd						" " " " "
3rd						" " " " "
4th						" " " " "

(See Reverse for Record of Formation)

RECORD OF FORMATIONS

FORMATION	TOP	BOTTOM	REMARKS
Surface and sand	0	105	
Sand and red bed	105	550	
Shale and shells	550	1448	Set and cemented 8-5/8" OD, 24' 8" thd., R-2, J-55, 3.3. casing (A cond.) at 1448' with 700 sacks of Pozmix cement, 300 sacks of common cement and 2% calcium chloride. Finished 11:50 a.m. 7/21/58. Cement circulated.
Shale and shells	1448	1765	
Lime and shale	1765	3005	
Lime, shale and chalk	3005	3620	
Shale and lime	3620	4710	TOP HEBNER SHALE 4363'
Lime	4710	5164	TOP LAHSING LIME 4513' TOP NARMATON LIME 5157' Ran Halliburton drill stem test No. 1, packer set at 5140', used 24' anchor, open 1 hour, gas to surface in 2 mins., gas gauged 180 MCF in 15 mins., 80 MCF in 30 mins., 53 MCF in 45 mins., and 53 MCF at end of 1 hour, recovered 90' of heavy oil and gas and 60' of mud and cut oil, 70' of free oil and 770' of salt water, IBHP-1722', IFF-100', FFP-279', FBHP-1450' in 20 minutes.

FORMATION	TOP	BOTTOM	REMARKS
Lime	5164	5234	Ran Halliburton drill stem test No. 2, packer set at 5225' SLM, used 26' anchor, open 50 mins., no blow, recovered 130' of drilling mud, IBHP-1199', IFF-99', FFP-160', FBHP-1005' in 20 mins.
SLM CORRECTION	5234	5251	5234' RM equals 5251' SLM
Lime	5251	5712	TOP CHEROKEE LIME 5373' TOP MORROW SHALE 5684'

Cored from 5712' to 5737' - Recovered 25'

Top 1'6"	Lime, dark gray, coarse crystalline, tight	Date
Next 1'	Shale, black rotten	
Next 2'6"	Lime, brown to black, fine crystalline, dense, hard	
Next 1'	Shale, black and rotten	
Next 4'6"	Lime, tan to brown, fine crystalline, fossiliferous, cherty	
Next 4'6"	Sand, white, very fine grained, good porosity, fair	
Next 2'	Sand, white, very fine grained, extremely reworked with black shale, fair porosity, bleeding gas with few spots bleeding oil, fair oil nests	
Next 3'6"	Sand as above, less shaly	
Next 2'	Shale, black and rotten	
Last 2'6"	Lime, black, medium crystalline, fossiliferous	

FORMATION	TOP	BOTTOM	REMARKS
Lime and shale	5737	5810	TOP MORROW SAND 5712' Ran Halliburton drill stem test No. 3, packer set at 5717', used 20' anchor, open 1 hour, good blow throughout test, gas gauged 1,930 MCF, recovered 120' of gas cut muddy salt water, IBHP-1990', IFF-91', FFP-281', FBHP-1919' in 20 minutes.

FORMATION	TOP	BOTTOM	REMARKS
Lime and shale	5810	5880	TOP CHESTER 5780' Ran Halliburton drill stem test No. 4, packer set at 5740', used 70' anchor, open 1 hour, very weak blow for 21 minutes, recovered 92' of drilling mud, IBHP-1149', IFF-58', FFP-58', FBHP-78' in 20 minutes.
TOTAL DEPTH 5880'			Ran Schlumberger Laterolog Survey. Ran Halliburton drill stem test No. 5, packer set at 5815', used 69' anchor, open 1 hour, very weak blow for 17 minutes, recovered 50' of drilling mud, IBHP-78', IFF-58', FFP-58', FBHP-58' in 20 minutes.

(See Reverse for Record of Formations)

RECEIVED
STATE CORPORATION COMMISSION

JAN 6 1966

CONSERVATION DIVISION
Wichita, Kansas

Set and cemented 5927'6" of 5 1/2" casing at 5880 with 200 sacks of common cement and 500 gallons of Dowell Cement. Finished 2:30 a.m. 8/22/58. Welex Temperature Survey showed top of cement behind 5 1/2" casing at 4820'.

Rigged up cable tools and swabbed hole down on August 24. Drilled cement plug to 5820'SLM and ran McCullough Collar Log.

Perforated 5 1/2" casing from 5712' to 5720' with 32 holes by McCullough regular bullets, gas gauged 1,010 MCF. Treated through 5 1/2" casing from 5712' to 5720' with 500 gallons of Halliburton 15% mud acid as follows:

ACID TREATMENT NO. 1 - Between 5712' and 5720'

Treatment put in 8/25/58 by Halliburton, using 500 gallons of acid and 131 barrels of water.

TIME	CP	TP	REMARKS
11:47 pm	200%		Start acid
12:01 am	400%		Acid on bottom
12:08 am	200%		500 gallons of acid in

Swabbed through 5 1/2" casing 2 1/2 hours and well started flowing. Flowed through 5 1/2" casing 5 hours, gas gauged 1,220 MCF. On August 26, flowed through 5 1/2" casing 3 hours, gas gauged 1,646 MCF. Ran Halliburton Vis-O-Frac as follows:

VIS-O-FRAC TREATMENT NO. 1 - Between 5712' and 5720'

Used 500 gallons of gelled kerosene followed by 3000 gallons gelled kerosene, 3000# sand, Maximum CP-2000%, minimum CP-1650%, Time 3 minutes, Injection 30.1 barrels per minute, 6000 gallons water to flush

Swabbed through 5 1/2" casing, fluid used in treating and well started flowing. Flowed through 5 1/2" casing 2 hours, gas gauged 5,150 MCF. Shut in 11 hours, then flowed through 5 1/2" casing 1 hour, gas gauged 6,373 MCF.

Set Baker bridging plug at 5250' and plugged back with 1/2 sack of Cal-Seal from 5250' to 5246'. Perforated 5 1/2" casing from 5234' to 5240' with 24 McCullough M-3 holes, no shows. Treated through 5 1/2" casing with 500 gallons of Halliburton 15% mud acid as follows:

ACID TREATMENT NO. 2 - Between 5234' and 5240'

Treatment put in 8/27/58 by Halliburton, using 500 gallons of acid and 126 barrels of water.

TIME	CP	TP	REMARKS
3:25 pm			Start acid
3:30 pm			500 gallons acid in
3:40 pm	250%		
3:51 pm	50%		Finished flush

Swabbed out water used in treating, then swabbed through 5 1/2" casing 10 hours, 7 1/2 barrels of fluid per hour, 10% oil, balance water. On August 28, swabbed through 5 1/2" casing 2 hours, 7 1/2 barrels of fluid per hour, 10% oil.

Ran 2" tubing and set DN retainer at 5215'. Tried to squeeze cement off perforations from 5234' to 5240' with 225 sacks of common cement, would not pressure up. Let set 4 hours, then recemented with 125 sacks of common cement, TP-5000#. Raised 2" tubing and shut down for cement to set.

On August 30, pulled 2" tubing and swabbed the hole dry. Drilled cement plug to 5240', hole dry. Loaded hole with 30 barrels of water and drilled and drove retainer at 5215' and bridging plug at 5250' to 5795'SLM.

PLUGGED BACK TOTAL DEPTH 5795'

Ran 2" tubing, then swabbed through 2" tubing 30 minutes and well started flowing. Flowed through 2" tubing 4 hours to clean up hole, gas gauged 2,930 MCF, CP-500%. Moved out cable tools and shut in to flow intermittently.

SI CP-1650%. On September 6, flowed through 5 1/2" casing with two 2" openings 1 hour, then shut casing valve and flowed through 2" tubing 1 1/2 hours to clean up hole, gas gauged 3,210 MCF, CP-710%. Shut in for pipe line connection.

SLOPE TEST DATA
ANGLE OF DEFLECTION

DEPTH	ANGLE OF DEFLECTION
300'	1/4 Degree
1100'	0
1250'	0
1255'	1/4
1700'	0
1765'	0
2100'	0
2500'	0
2850'	0
3215'	0
3725'	1/2
3835'	3/4
4125'	3
4190'	2-3/4
4250'	2
4310'	2
4370'	1 1/2
4430'	1 1/2
4510'	1 1/2
4565'	1
4628'	1 1/2
4685'	1
4738'	1
4830'	1 1/2
4889'	1 1/2
4945'	1-3/4
4955'	1 1/2
4960'	1 1/2
5055'	1 1/2
5092'	1 1/2
5178'	1 1/2
5234'	1
5354'	3/4
5448'	1/2
5555'	1
5671'	1
5781'	1

RECEIVED

JAN 8 1988

CONSERVATION DIVISION

STATE CORPORATION COMMISSION






