

15-119-20168-0000

STATE OF KANSAS  
STATE CORPORATION COMMISSION


Form CP-4

WELL PLUGGING RECORD

Give All Information Completely  
Make Required Affidavit  
Mail or Deliver Report to:  
Conservation Division  
State Corporation Commission  
212 No. Market  
Wichita, Kansas

Meade County, Sec 1 Twp. 34S Rge. (E) 29 (W)  
2310 FNL & 1420' FEL

NORTH

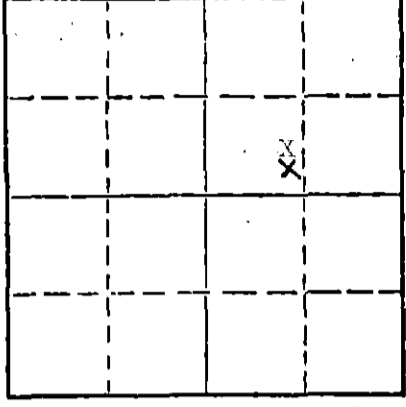

Locate well correctly on above Section Plat

Location as "NE/CNW&SW" or footage from lines  
Lease Owner: Alpar Resources, Inc.  
Lease Name: B.W. Borchers, Well No. 1  
Office Address: P. O. Box 906, Perryton, Texas 79070  
Character of Well (completed as Oil, Gas or Dry Hole): Dry Hole  
Date well completed: 7/23/74 19 74  
Application for plugging filed Phone: 7/23/74 19 74  
Application for plugging approved: 7/23 19 74  
Plugging commenced: 7/23 19 74  
Plugging completed: 7/23 19 74  
Reason for abandonment of well or producing formation:

If a producing well is abandoned, date of last production: 19  
Was permission obtained from the Conservation Division or its agents before plugging was commenced? Yes

Name of Conservation Agent who supervised plugging of this well:  
Producing formation: Depth to top: Bottom: Total Depth of Well: 5800 Feet  
Show depth and thickness of all water, oil and gas formations.

OIL, GAS OR WATER RECORDS

CASING RECORD

FORMATION	CONTENT	FROM	TO	SIZE	PUT IN	PULLED OUT
		0	1334	8 5/8	1334'	None

Describe in detail the manner in which the well was plugged, indicating where the mud fluid was placed and the method or methods used in introducing it into the hole. If cement or other plugs were used, state the character of same and depth placed, from feet to feet for each plug set.

1st plug 50 sx. @ 1400'  
2nd plug 15 sx. @ 45' to surface

RECEIVED  
STATE CORPORATION COMMISSION  
JUL 29 1974  
CONSERVATION DIVISION  
Wichita, Kansas

(If additional description is necessary, use BACK of this sheet)  
Name of Plugging Contractor: Zenith Drilling Corporation, Inc.  
Address: Suite 600 - 200 West Douglas, Wichita, Kansas 67204

STATE OF Kansas, COUNTY OF Sedgwick, ss.  
C. Robert Buford (employee of owner) or (owner or operator) of the above-described well, being first duly sworn on oath, says: That I have knowledge of the facts, statements, and matters herein contained and the log of the above-described well as filed and that the same are true and correct. So help me God.

(Signature) C. Robert Buford  
Suite 600 - 200 West Douglas, Wichita, Ks.  
(Address)

Subscribed and sworn to before me this 26th day of July, 19 74

My commission expires 8/15/75

Myrna D. Murphy  
Notary Public.

# WELL LOG

COMPANY ALPAR RESURCES, INC.

SEC. 1-34S-29W

FARM B.W. BORCHERS NO. 1

LOC. 2310' FNL & 1420' EEL

TOTAL DEPTH 5800'


COUNTY Meade

COMM. 7/11/74

COMP. 7/23/74

CONTRACTOR ZENITH DRILLING CORPORATION, INC.

CASING 1334' of 8 5/8" w/650 sx cement

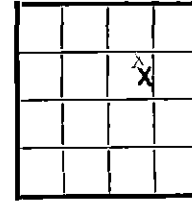

ELEVATION

PRODUCTION

FIGURES INDICATE BOTTOM OF FORMATIONS

165	Clay & Sand
1428	Red Bed & Anhydrite
3045	Red Bed & Shale
5465	Lime
5585	Lime & Shale
5800	Lime, Shale & Sand

RECEIVED  
 STATE CORPORATION COMMISSION  
 JUL 29 1974  
 CONSERVATION DIVISION  
 Wichita, Kansas

State of Kansas }  
 County of Sedgwick } ss

I, C. Robert Buford, President of Zenith Drilling Corporation, Inc.  
 upon oath state the above and foregoing is a true and correct copy of the log of the B.W. Borchers # 1 well.

C. Robert Buford

Subscribed and sworn to before me this 26 day of July, 1974

My Commission Expires: 8/15/75

Myrna D. Murphy  
 Myrna D. Murphy NOTARY PUBLIC