


STATE OF KANSAS
STATE CORPORATION COMMISSION

WELL PLUGGING RECORD

Give All Information Completely
Make Required Affidavit
Mail or Deliver Report to
Conservation Division
State Corporation Comm.
245 North Water
Wichita, KS 67202

Meade County, Sec. 35 Twp. 34S Rge. 28W E/W
Location as "NE/CNW $\frac{1}{4}$ SW $\frac{1}{4}$ " or footage from lines
SE SW NW/4

Lease Owner R.J. Patrick Operating
Lease Name Rhodes Well No. 1
Office Address Box 1314 Liberal, Kansas 67901
Character of Well (Completed as Oil, Gas or Dry Hole)
Dry Hole

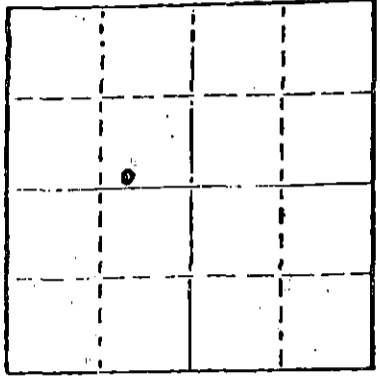

Locate well correctly on above
Section Plat

Date Well completed 12-28 1978
Application for plugging filed 2-5 1979
Application for plugging approved 2-9 1979
Plugging commenced 2-6 1979
Plugging completed 2-8 1979
Reason for abandonment of well or producing formation

If a producing well is abandoned, date of last production 19

Was permission obtained from the Conservation Division or its agents before plugging was commenced? Yes

Name of Conservation Agent who supervised plugging of this well Clarence Thomas
Producing formation Depth to top Bottom Total Depth of Well 3410
Show depth and thickness of all water, oil and gas formations.

OIL, GAS OR WATER RECORDS

CASING RECORD

FORMATION	CONTENT	FROM	TO	SIZE	PUT IN	PULLED OUT
				8 5/8	531	none
				5 1/2	3410	2145

Describe in detail the manner in which the well was plugged, indicating where the mud fluid was placed and the method or methods used in introducing it into the hold. If cement or other plugs were used, state the character of same and depth placed, from feet to feet for each plug set.

Pump 20 sks. of cement @ 2850 to 3141
Pump 35 sks. of cement @ 500 to 400
Put 10 sks. of cement @ 40 to 0

RECEIVED
STATE CORPORATION COMMISSION
FEB 26 1979
2-26-79
CONSERVATION DIVISION
Wichita, Kansas

(If additional description is necessary, use BACK of this sheet)

Name of Plugging Contractor Sargent's Casing Pulling Service Bbx 506 Liberal, Kansas 67901

STATE OF Kansas COUNTY OF Seward, ss.
R.J. Patrick (employee of owner) or (owner or operator)
of the above-described well, being first duly sworn on oath, says: That I have knowledge of the facts, statements, and matters herein contained and the log of the above-described well as filed and that the same are true and correct. So help me God.

(Signature) R.J. Patrick
Box 1314 Liberal Kansas
(Address)

SUBSCRIBED AND SWORN TO before me this 23 day of February, 1979

My commission expires January 15, 1983
Jay Easley
Notary Public.

KANSAS DRILLER'S LOG

LEASE: RHODES #1
OWNER: R.J. PATRICK OPERATING COMPANY
CONT: EARL F. WAKEFIELD, INC.
SPUD: 12-6-78
COMP: 12-14-78

LOCATION: SECTION 35-34S-28W
MEADE COUNTY,
KANSAS
CASING: 8 5/8" SET @ 530'
5 1/2" SET @ 3410'

Surface Sand & Red Bed	531
Red Bed - Gyp, Sand & Shale	755
Shale	1092
Shale & Gyp	1605
Shale - Gyp	2000
Shale & Anhydrite Streaks	2290
Shale & Lime	2710
Lime & Shale	2865
Shale & Lime	2985
Lime & Shale	3237
Shale - Lime	3350
Lime & Shale	3410
R.T.D.	3410

RECEIVED
STATE CORPORATION COMMISSION
FEB - 6 1979
CONSERVATION DIVISION
Wichita, Kansas

STATE OF KANSAS)
) ss.
COUNTY OF SEDGWICK)

I, William C. Wakefield, do hereby certify that this is a true and correct log on the RHODES #1, located SECTION 35-34S-28W, MEADE COUNTY, KANSAS, as shown by the daily drilling reports.

EARL F. WAKEFIELD, INC.

By: William C. Wakefield
William C. Wakefield

Subscribed and Sworn to before me this 28th day of December, 1978.

My Appointment Expires:
4/30/79

Dorothy L. Schmidt

DOROTHY L. SCHMIDT
STATE NOTARY PUBLIC
Sedgwick County, Kansas
My Appt. Exp. April 30, 1979