


WELL PLUGGING RECORD

Handwritten initials

Give All Information Completely
Make Required Affidavit
Mail or Deliver Report to:
Conservation Division
State Corporation Commission
211 No. Broadway
Wichita, Kansas

Summer County. Sec. 22 Twp. 31S Rge. (E) 3 (W)

Location as "NE/CNW/SW" or footage from lines NSW:SW:SW
Lease Owner Herndon Drilling Co.
Lease Name A. Subera Well No. 2
Office Address Box 489 Tulsa, Okla.
Character of Well (completed as Oil, Gas or Dry Hole) Oil
Date well completed 2-23 19 57
Application for plugging filed 19
Application for plugging approved 19
Plugging commenced 7-15 19 63
Plugging completed 7-15 19 63
Reason for abandonment of well or producing formation

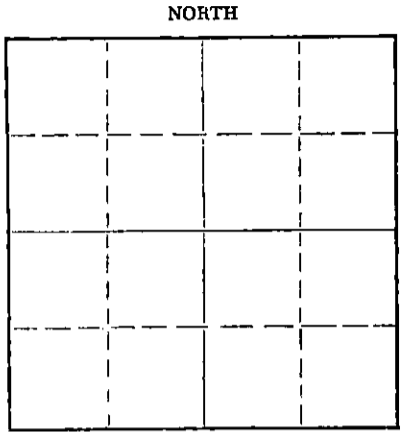

Locate well correctly on above Section Plat

If a producing well is abandoned, date of last production 8-31 19 63
Was permission obtained from the Conservation Division or its agents before plugging was commenced? Yes

Name of Conservation Agent who supervised plugging of this well Howard Hess
Producing formation Simpson sand Depth to top 4740' Bottom 4744' Total Depth of Well 4744' Feet
Show depth and thickness of all water, oil and gas formations.

OIL, GAS OR WATER RECORDS CASING RECORD

FORMATION	CONTENT	FROM	TO	SIZE	PUT IN	PULLED OUT

Describe in detail the manner in which the well was plugged, indicating where the mud fluid was placed and the method or methods used in introducing it into the hole. If cement or other plugs were used, state the character of same and depth placed, from feet to feet for each plug set.
Fill open hole w/gravel from 4744' to 4730'. Dump 5 sacks cement w/ dump bailer. Pull 600' of 5 1/2" casing. Dump 6' rock bridge, dump 5 sacks cement on top of bridge. Fill up w/mud to 17' of top. Dump 4' rock bridge & 5 sacks cement on top.

RECEIVED
STATE CORPORATION COMMISSION

AUG 15 1963

CONSERVATION DIVISION
Wichita, Kansas

(If additional description is necessary, use BACK of this sheet)

Name of Plugging Contractor Winfield Oil Field Ser. Inc.
Address Box 952 Winfield, Kansas

STATE OF Oklahoma, COUNTY OF Tulsa, ss.
Seth Herndon, Jr. (employee of owner) or (owner or operator) of the above-described well, being first duly sworn on oath, says: That I have knowledge of the facts, statements, and matters herein contained and the log of the above-described well as filed and that the same are true and correct. So help me God.

(Signature) Seth Herndon, Jr.
Seth Herndon, Jr.
Box 489, Tulsa, Oklahoma
(Address)

SUBSCRIBED AND SWORN to before me this 14th day of August, 19 63

My commission expires June 19, 1965

Johnnie Alene Frese
Johnnie Alene Frese Notary Public.



WELL LOG ON A. SUBERA #2

Spudding date: 1/19/57
Date casing set: 1/20/57
Date rotary completed: 2/15/57
Date cable completed:

Location:

SW SW SW, Section 22-34S-3W, Sumner County, Kansas

FROM	TO	FORMATION	REMARKS
0	653	Surface Hole	Ran 21 Jts. 8-5/8" 24# Casing, set @ 654' and cemented w/475 Sx. Cement.
653	1050	Shale	
1050	1235	Shale & Shells	
1235	1385	Shale & Lime	
1385	1470	Lime	
1470	3200	Lime & Shale	
3200	3305	Sand & Shale	
3305	3435	Lime & Shale	
3435	3535	Shale	
3535	3630	Shale & Lime	
3630	3710	Lime	
3710	3780	Lime & Shale	
3780	3824	Lime	
3824	4237	Shale & Lime	
4237	4255	Shale	
4255	4315	Shale & Lime	
4315	4336	Lime	
4336	4374	Lime & Shale	
4374	4475	Lime	
4475	4503	Lime & Shale	
4503	4557	Lime	
4557	4570	Lime & Shale	
4570	4618	Lime	
4618	4744	Lime & Shale	
4744		Total Depth	Ran 147 Jts. 5 1/2" 14# Casing, set @ 4740' and cemented w/175 Sx. Pozmix on bottom. D.V. Tool @ 1530', cemented w/250 Sx. Pozmix.

RECEIVED
STATE CORPORATION COMMISSION

AUG 15 1963

CONSERVATION DIVISION
Wichita, Kansas

Subscribed and sworn to before me this 25th day of February, 19 57

I certify the above and foregoing to be a true and exact copy of the original driller's log on the A. Subera #2.

HERNDON DRILLING COMPANY

Notary Public
My commission expires: 1/27/60

By:
Title: Assistant Secretary