


STATE OF KANSAS
STATE CORPORATION COMMISSION

WELL PLUGGING RECORD

Give All Information Completely
Make Required Affidavit
Mail or Deliver Report to
Conservation Division
State Corporation Comm.
245 North Water
Wichita, KS 67202

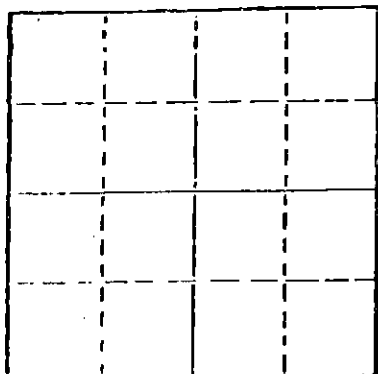

Locate well correctly on above
Section Plat

Summer County. Sec. 21 Twp. 34S Rge. 3 ~~NE~~/W
Location as "NE/CNW $\frac{1}{4}$ SW $\frac{1}{4}$ " or footage from lines
NE NE NW Sec. 21-34S-3W
Lease Owner D N B Drilling, Inc.
Lease Name Shoffner Well No. 1
Office Address Suite 515, R.H. Garvey Bldg., Wichita, Ks.
Character of Well (Completed as Oil, Gas or Dry Hole) dry hole

Date Well completed 12-20-77 1977
Application for plugging filed 12-20-77
Application for plugging approved 12-20-77
Plugging commenced 12-20-77
Plugging completed 12-20-77

Reason for abandonment of well or producing formation
no commercial quantities of oil or gas encountered

If a producing well is abandoned, date of last production
19

Was permission obtained from the Conservation Division or
its agents before plugging was commenced? yes

Name of Conservation Agent who supervised plugging of this well Carl Burnett
Producing formation Depth to top Bottom Total Depth of Well 4370
Show depth and thickness of all water, oil and gas formations.

OIL, GAS OR WATER RECORDS

CASING RECORD

FORMATION	CONTENT	FROM	TO	SIZE	PUT IN	PULLED OUT
surface hole	shale	surf	255	8-5/8	252	none

Describe in detail the manner in which the well was plugged, indicating where the mud fluid
was placed and the method or methods used in introducing it into the hold. If cement or other
plugs were used, state the character of same and depth placed, from feet to
feet for each plug set.

Fluid to 260', plug, 20 sx
Fluid to 40', plug, 40 sx
Rat Hole - 2 sx

RECEIVED
STATE CORPORATION COMMISSION

JAN 03 1978

CONSERVATION DIVISION
Wichita, Kansas

(If additional description is necessary, use BACK of this sheet)

Name of Plugging Contractor D N B DRILLING, INC.
515 R. H. Garvey Building
Wichita, Kansas 67202

STATE OF Kansas COUNTY OF Sedgwick, ss.
Ella Priess (employee of owner) or (owner or operator)
of the above-described well, being first duly sworn on oath, says: That I have knowledge of
the facts, statements, and matters herein contained and the log of the above-described well
as filed and that the same are true and correct. So help me God.

(Signature) Ella Priess
Suite 515, R.H. Garvey Bldg., Wichita, Ks.
(Address)

SUBSCRIBED AND SWORN TO before me this 21st day of Dec, 1977

My commission expires 4/30/79

Dorothy L. Schmidt
Notary Public.

DOROTHY L. SCHMIDT
STATE NOTARY PUBLIC
Sedgwick County, Kansas
My Appt. Exp. April 30, 1979

DRILLERS' LOG

D N B DRILLING, INC.
No. 1 Shoffner
NE NE NW Sec. 21-34S-3W
Sumner County, Kansas

Commenced: 12-14-77
Completed: 12-20-77

Surface Casing: 252.30' of 8-5/8"
cemented w/140 sx, 3% cc, 2% gel
12-14-77

FORMATION

DEPTH

Surface Hole	0 - 255
Shale	255 - 920
Shale & Lime	920 - 1645
Lime & Shale	1645 - 3500
Lime	3500 - 3695
Lime & Shale	3695 - 4040
Lime	4040 - 4190
Lime & Shale	4190 - 4340
Lime	4340 - 4370 RTD

I do hereby certify that the foregoing statements are true and correct to the best of my knowledge and belief.

D N B DRILLING, INC.

Ella Priess

Ella Priess

STATE OF KANSAS: ss:

Subscribed and sworn to before me this 27th day of December, 1977.

Dorothy L. Schmidt
Dorothy L. Schmidt, Notary Public

RECEIVED
STATE CORPORATION COMMISSION

JAN 03 1978

CONSERVATION DIVISION
Wichita, Kansas

DOROTHY L. SCHMIDT
STATE NOTARY PUBLIC
Sedgewick County, Kansas
My Appt. Exp. April 30, 1979