


STATE OF KANSAS
STATE CORPORATION COMMISSION

Give All Information Completely
Make Required Affidavit
Mail or Deliver Report to:
Conservation Division
State Corporation Commission
212 North Market, Insurance Bldg.
Wichita, Kansas

WELL PLUGGING RECORD

SUMNER County. Sec. 21 Twp. 34S Rge. 3W (#) (W)

NORTH

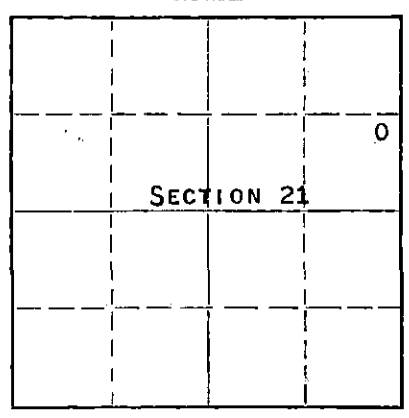

Locate well correctly on above
Section Plat

Location as "NE/CNW/SW" or footage from lines NE SE NE
Lease Owner PETROLEUM, INC.
Lease Name MI SAK Well No. 1
Office Address ROUTE 2, GREAT BEND, KANSAS
Character of Well (completed as Oil, Gas or Dry Hole) DRY HOLE
Date well completed NOVEMBER 14 19 59
Application for plugging filed NOVEMBER 14 19 59
Application for plugging approved NOVEMBER 14 19 59
Plugging commenced NOVEMBER 14 19 59
Plugging completed NOVEMBER 14 19 59
Reason for abandonment of well or producing formation NO PRODUCIBLE ZONES

If a producing well is abandoned, date of last production NONE 19
Was permission obtained from the Conservation Division or its agents before plugging was commenced? YES

Name of Conservation Agent who supervised plugging of this well EUGENE GRAHAM, WINFIELD, KANSAS
Producing formation --- Depth to top --- Bottom --- Total Depth of Well 4782' Feet
Show depth and thickness of all water, oil and gas formations.

OIL, GAS OR WATER RECORDS

CASING RECORD

FORMATION	CONTENT	FROM	TO	SIZE	PUT IN	PULLED OUT
				8-5/8"	675'	NONE

Describe in detail the manner in which the well was plugged, indicating where the mud fluid was placed and the method or methods used in introducing it into the hole. If cement or other plugs were used, state the character of same and depth placed, from feet to feet for each plug set.

MUD UP WITH HEAVY MUD TO 240', PUSHED DOWN 1/4 SACK HULLS TO 240' FOLLOWED BY WOODEN PLUG. PLACED 15 SACKS CEMENT THROUGH DRILL PIPE ON TO PLUG. MUD UP WITH HEAVY MUD TO 35' AND PLACED 1/4 SACK HULLS AT 35' FOLLOWED BY WOODEN PLUG AND 10 SACKS CEMENT TO BASE OF WELL CELLAR.

RECEIVED
STATE CORPORATION COMMISSION
DEC 10 1959
CONSERVATION DIVISION
Wichita, Kansas

(If additional description is necessary, use BACK of this sheet)
Name of Plugging Contractor GARVEY DRILLING COMPANY
Address ROUTE 2, GREAT BEND, KANSAS

STATE OF KANSAS, COUNTY OF BARTON, ss.
DON SEARLE (employee of owner) or (~~*****~~) of the above-described well, being first duly sworn on oath, says: That I have knowledge of the facts, statements, and matters herein contained and the log of the above-described well as filed and that the same are true and correct. So help me God.

(Signature) Don Searle
ROUTE 2, GREAT BEND, KANSAS
(Address)

SUBSCRIBED AND SWORN TO before me this 8TH day of DECEMBER, 19 59

Arthur J. Miles
Notary Public.

My commission expires APRIL 14, 1963

WELL LOG

COMPANY PETROLEUM, INCORPORATED

SEC. 21 T-34S R. 3W

FARM MISAK

NO. 1

LOC. NE, SE, NE


TOTAL DEPTH 4782'

COUNTY SUMNER CO., KANSAS

COMM. October 29, 1959

COMP. November 14, 1959

CONTRACTOR GARVEY DRILLING COMPANY

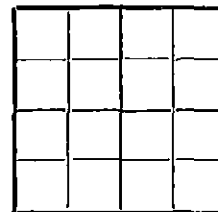

CASING 8 5/8" @ 675' W/400 sax.

ELEVATION 1202' DF

PRODUCTION D & A

FIGURES INDICATE BOTTOM OF FORMATIONS

360	Red bed & shale
660	Blue shale
675	Lime & shale
1105	Lime w/shale streaks
1325	Lime
2055	Lime & shale
2285	Shale & lime
2646	Lime & shale
2710	Lime
2750	Shale
2921	Lime & shale
3125	Shale & lime
3258	Lime & shale
3365	Shale & sand
3505	Shale
3668	Sand & shale
4060	Lime & shale
4302	Shale & lime
4325	Chert
4423	Lime
4499	Cherty lime
4542	Cherty lime & shale
4568	Cherty lime
4608	Cherty lime & shale
4639	Cherty lime
4656	Cherty lime & pyrite
4782	Lime & shale
4782	T. D.

RECEIVED
 STATE CORPORATION COMMISSION
 DEC 10 1959
 CONSERVATION DIVISION
 Wichita, Kansas

State of KANSAS }
 County of BARTON } ss:

I, VERNE A. MORRIS of GARVEY DRILLING COMPANY

upon oath state that the above and foregoing is a true and correct copy of the log of the #1 MISAK well.

Verne A. Morris

Subscribed and sworn to before me this 4th day of December 19 59

My Commission Expires: April 14, 1963

Arthur J. Wiles
 NOTARY PUBLIC