

STATE OF KANSAS
STATE CORPORATION COMMISSION


WELL PLUGGING RECORD

Give All Information Completely
Make Required Affidavit
Mail or Deliver Report to:
Conservation Division
State Corporation Commission
212 North Market, Insurance Bldg.
Wichita, Kansas

Sumner County. Sec. 21 Twp. 34 S Rge. (E) 3 (W)

Location as "NE/CNW/SW" or footage from lines 330' fr NL & 330' fr WL
Lease Owner Phillips Petroleum Co.
Lease Name Baker "K" Well No. 1
Office Address Box 779 Great Bend, Kans.
Character of Well (completed as Oil, Gas or Dry Hole) Dry Hole
Date well completed Jan. 10 19 61
Application for plugging filed Jan. 10 19 61
Application for plugging approved Jan. 10 19 61
Plugging commenced Jan. 11 19 61
Plugging completed Jan. 11 19 61
Reason for abandonment of well or producing formation Dry hole

NORTH

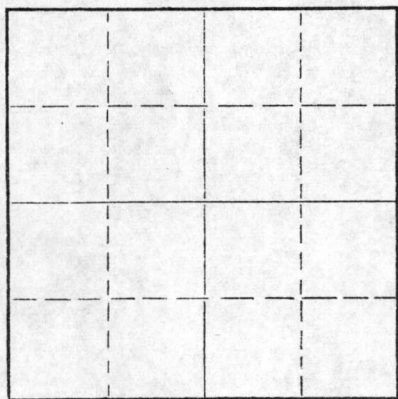

Locate well correctly on above Section Plat

If a producing well is abandoned, date of last production 19
Was permission obtained from the Conservation Division or its agents before plugging was commenced? Yes

Name of Conservation Agent who supervised plugging of this well Lee N. Guthrie
Producing formation Simpson sand (Dry) Depth to top 4774' Bottom Total Depth of Well 4820 Feet
Show depth and thickness of all water, oil and gas formations.

OIL, GAS OR WATER RECORDS

CASING RECORD

FORMATION	CONTENT	FROM	TO	SIZE	PUT IN	PULLED OUT
Heebner		2844		8-5/8"	611.55'	None
Toront.		2894				
Douglas Sand		2996				
Stalnaker		3262				
Miss.		4324				
Viola		4770				
Simpson Sand		4774				

Describe in detail the manner in which the well was plugged, indicating where the mud fluid was placed and the method or methods used in introducing it into the hole. If cement or other plugs were used, state the character of same and depth placed, from feet to feet for each plug set.

Mudded hole from 4820' to 240'. Set Howco wood plug @ 240', dumped 15 sx cement to 205', mudded hole to 35', dumped 10 sx cement to base of cellar.

RECEIVED
STATE CORPORATION COMMISSION
JAN 16 1961
1-16-61
CONSERVATION DIVISION
Wichita, Kansas

(If additional description is necessary, use BACK of this sheet)

Name of Plugging Contractor Garvey Drilling Co.
Address Route #2 Great Bend, Kansas

STATE OF Kansas, COUNTY OF Barton, ss.
M. E. Michael (employee of owner) or (owner or operator) of the above-described well, being first duly sworn on oath, says: That I have knowledge of the facts, statements, and matters herein contained and the log of the above-described well as filed and that the same are true and correct. So help me God.

(Signature) M. E. Michael
Box 779 Great Bend, Kansas
(Address)

SUBSCRIBED AND SWORN TO before me this 12th day of January, 19 61

My commission expires Nov. 18, 1961
Joseph M. Beal Notary Public.



EXPLORATION RECORD

Lease Baker "K"

Well 1

Formation Name	Top	Base	Remarks
Surface soil & red bed	0	130	
Red bed, shale, lime	130	490	
Lime	490	835	
Lime & shale	835	1150	
Lime	1150	1250	
Lime & shale	1250	3370	
Shale	3370	3578	
Lime	3578	3758	
Lime & shale	3758	3885	
Shale	3885	3912	
Lime & shale	3912	3793	
Shale	3793	4029	
Lime	4029	4120	
Lime & shale	4120	4240	
Shale	4240	4325	
Lime & chert	4325	4355	
Lime	4355	4490	
Lime & shale	4490	4533	
Lime	4533	4667	
Lime & shale	4667	4715	
Lime	4715	4772	
Lime & shale	4772	4780	
Lime	4780	4801	
Lime & shale	4801	4820	
FORMATION TOPS - WELLEX RADIATION GUARD LOG			
Heebner	2844		
Toronto	2894		
Douglas Shale	2996		
Stalnaker	3262		
Miss.	4324		
Viola	4770		
Simpson Sand	4774		

ST. ...
 ...
 ...
 ...