

Give All Information Completely
Make Required Affidavit
Mail or Deliver Report to:
Conservation Division
State Corporation Commission
212 No. Market
Wichita, Kansas

WELL PLUGGING RECORD

Morton County, Sec. 31 Twp. 33S Rge. 42 (E) X (W)

Location as "NE/CNW/SW" or footage from lines 1260' FNL & 2471' FEL

Lease Owner Gas Producing Enterprises, Inc.

Lease Name Stuckey Well No. 2-31

Office Address P. O. Box 1332, Amarillo, Texas 79189

Character of Well (completed as Oil, Gas or Dry Hole) Dry hole

Date well completed May 6 1979

Application for plugging filed May 6 1979

Application for plugging approved May 9 1979


Plugging commenced May 6 1979

Plugging completed May 6 1979

Reason for abandonment of well or producing formation dry hole

If a producing well is abandoned, date of last production 19

Was permission obtained from the Conservation Division or its agents before plugging was commenced? yes

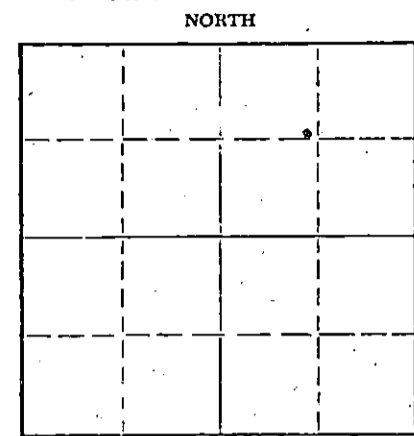

Locate well correctly on above Section Plat

Name of Conservation Agent who supervised plugging of this well Gilbert Balthazor

Producing formation none Depth to top Bottom Total Depth of Well Feet

Show depth and thickness of all water, oil and gas formations.

OIL, GAS OR WATER RECORDS

CASING RECORD

FORMATION	CONTENT	FROM	TO	SIZE	PUT IN	PULLED OUT
Surface clay sand Redbed		0	618			
Sand - Redbed - anhydrite		618	966			
Sand - Redbed		966	1174			
Redbed		1174	1233			
Red - Anhydrite		1233	1363	8 5/8	34 jts	
Anhydrite - Shale		1363	1380			
Redbed - Shale		1380	1880			
Redbed - Sand - Shale		1880	2213			
Lime - shale		2213	4940			

Describe in detail the manner in which the well was plugged, indicating where the mud fluid was placed and the method or methods used in introducing it into the hole. If cement or other plugs were used, state the character of same and depth placed, from 150 feet to 25 feet for each plug set.

Set 55 sxs plug 1400' - 1250', set 15 sxs plug 40' to surface.

RECEIVED
STATE CORPORATION COMMISSION

MAY 31 1979

CONSERVATION DIVISION
Wichita, Kansas

(If additional description is necessary, use BACK of this sheet)

Name of Plugging Contractor Gabbert - Jones, Inc.

Address Wichita, Kansas

STATE OF Texas, COUNTY OF Potter, ss.

(employee of owner) or (owner or operator) of the above-described well, being first duly sworn on oath, says: That I have knowledge of the facts, statements, and matters herein contained and the log of the above-described well as filed and that the same are true and correct. So help me God.

(Signature) [Handwritten Signature]

(Address)

SUBSCRIBED AND SWORN TO before me this 21 day of May, 1979

My commission expires July 19, 1979

Notary Public.

GABBERT-JONES, INC.
WICHITA, KANSAS
DRILLERS' WELL LOG

Stuckey #2-31
1260' FNL & 2471' FEL Sec 31-33S-42W
Morton County Kansas

Commenced: 4-26-79

Completed: 5-6-79

OPERATOR: Gas Producing Enterprises, Inc.

Depth		Formation	Remarks
From	to		
0	618	Surface Clay-Sand-Redbed	Ran 34 jts of 24# 8 5/8" csg set @ 1363' Cemented w/550 sks L. W. 2% CC + 350 sks Common 3% CC PD @ 12:30 a.m. 4-28-79
618	966	Sand-Redbed-Anhy	
966	1174	Sand-Redbed	
1174	1233	Redbed	
1233	1363	Redbed-Anhy	
1363	1380	Anhy-Shale	
1380	1880	Redbed-Shale	
1880	2213	Redbed-Sand-Shale	
2213	4940	Lime-Shale	
	4940 - TD		

STATE OF KANSAS)
) SS
COUNTY OF SEDGWICK)

I, the undersigned, being duly sworn on oath, state that the above Drillers' Well Log is true and correct to the best of my knowledge and belief and according to the records of this office.

GABBERT-JONES, INC.

James S. Sutton II
JAMES S. SUTTON II

Subscribed and sworn to before me this 15th day of May, 1979.

Elizabeth J. Edwards
ELIZABETH J. EDWARDS-NOTARY PUBLIC

My Commission expires February 6, 1983.

RECEIVED
STATE CORPORATION COMMISSION
MAY 31 1979
CONSERVATION DIVISION
Wichita, Kansas

ELIZABETH J. EDWARDS
NOTARY PUBLIC
SEDGWICK CO. KANSAS