


15-129-20112-00-00

STATE OF KANSAS  
STATE CORPORATION COMMISSION

Form CP-4

Give All Information Completely  
Make Required Affidavit  
Mail or Deliver Report to:  
Conservation Division  
State Corporation Commission  
P. O. Box 17027  
Wichita, Kansas 67217  
NORTH

WELL PLUGGING RECORD

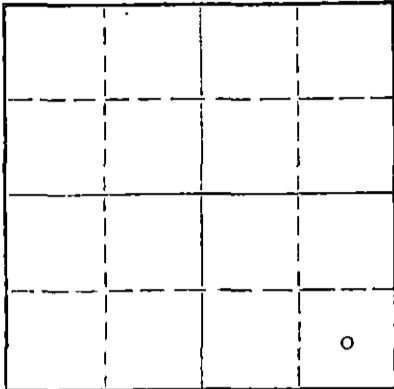

Locate well correctly on above  
Section Plat

Morton County, Sec. 32 Twp. 33 Rge. (E) 42 (W)  
Location as "NE/CNW&SW&" or footage from lines 100' S. of C SE SE  
Lease Owner Colorado Oil Company  
Lease Name McClain Well No. 44-32  
Office Address P. O. Box 749, Denver, Colorado 80201  
Character of Well (completed as Oil, Gas or Dry Hole) Dry Hole  
Date well completed May 19 19 73  
Application for plugging filed May 29 19 73  
Application for plugging approved May 23 19 73  
Plugging commenced May 19 19 73  
Plugging completed May 19 19 73  
Reason for abandonment of well or producing formation Dry

If a producing well is abandoned, date of last production 19  
Was permission obtained from the Conservation Division or its agents before plugging was commenced? Yes

Name of Conservation Agent who supervised plugging of this well E. Eves  
Producing formation Depth to top Bottom Total Depth of Well 4788 Feet  
Show depth and thickness of all water, oil and gas formations.

OIL, GAS OR WATER RECORDS

CASING RECORD

FORMATION	CONTENT	FROM	TO	SIZE	PUT IN	PULLED OUT
				13-3/8"	127'	None
				8-5/8"	1224'	None

Describe in detail the manner in which the well was plugged, indicating where the mud fluid was placed and the method or methods used in introducing it into the hole. If cement or other plugs were used, state the character of same and depth placed, from feet to feet for each plug set.

RTD 4788'

4788' to 1000' Heavy Mud

1000' to 900' 35 sx cement

900 to 35' Heavy Mud

35' to Surface 15 sx cement

RECEIVED  
STATE CORPORATION COMMISSION  
JUN 1 1973  
CONSERVATION DIVISION  
Wichita, Kansas

(If additional description is necessary, use BACK of this sheet)  
Name of Plugging Contractor Gabbert-Jones, Inc.  
Address 830 Sutton Place Wichita, Kansas 67202

STATE OF Colorado, COUNTY OF Denver, ss.  
Bill K. Henrichs (employee of owner) or (owner or operator) of the above-described well, being first duly sworn on oath, says: That I have knowledge of the facts, statements, and matters herein contained and the log of the above-described well as filed and that the same are true and correct. So help me God.

(Signature) *Bill K. Henrichs*  
P.O. Box 749, Denver, Colorado 80201  
(Address)

SUBSCRIBED AND SWORN TO before me this 30 day of May, 19 73

My commission expires August 25, 1976  
Cora M. Smith  
Notary Public.

