

STATE OF KANSAS
STATE CORPORATION COMMISSION


Form CP-4

WELL PLUGGING RECORD

Give All Information Completely
Make Required Affidavit
Mail or Deliver Report to:
Conservation Division
State Corporation Commission
211 No. Broadway
Wichita, Kansas

Seward County. Sec. 25 Twp. 34S Rge. 33 (W)

NORTH

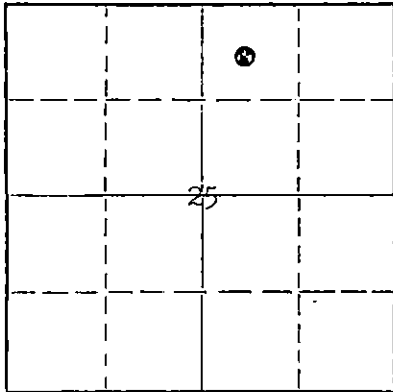

Locate well correctly on above
Section Plat

Location as "NE/CNW/SW" or footage from lines APPROX. C-NW-NE
Lease Owner Petroleum, Inc.
Lease Name Warden Well No. 3
Office Address Box 1255, Liberal, Kansas 67901
Character of Well (completed as Oil, Gas or Dry Hole) Dry Hole
Date well completed Oct. 29 19 69
Application for plugging filed Oct. 30 19 69
Application for plugging approved Oct. 31 19 69
Plugging commenced Oct. 29 19 69
Plugging completed Oct. 29 19 69
Reason for abandonment of well or producing formation -

If a producing well is abandoned, date of last production - 19
Was permission obtained from the Conservation Division or its agents before plugging was commenced? Yes

Name of Conservation Agent who supervised plugging of this well Ed Eyes
Producing formation - Depth to top - Bottom - Total Depth of Well 6420 Feet
Show depth and thickness of all water, oil and gas formations.

OIL, GAS OR WATER RECORDS

CASING RECORD

FORMATION	CONTENT	FROM	TO	SIZE	PUT IN	PULLED OUT
				8-5/8"	1569'	NONE

Describe in detail the manner in which the well was plugged, indicating where the mud fluid was placed and the method or methods used in introducing it into the hole. If cement or other plugs were used, state the character of same and depth placed, from feet to feet for each plug set.

Plugged with 35 sks. Halliburton cement 900' to 800'. 15 sks. cement 45' to G.L. Job complete at 1:15 A.M. 10/29/69.

RECEIVED
STATE CORPORATION COMMISSION
NOV 4 1969
CONSERVATION DIVISION
Wichita, Kansas

(If additional description is necessary, use BACK of this sheet)
Name of Plugging Contractor Garvey Drilling Company
Address P.O. Box 261, Great Bend, Kansas 67530

STATE OF Kansas, COUNTY OF Seward, ss.
Ned E. Lowry (employee of owner) or (owner or operator) of the above-described well, being first duly sworn on oath, says: That I have knowledge of the facts, statements, and matters herein contained and the log of the above-described well as filed and that the same are true and correct. So help me God.

(Signature) Ned E. Lowry
P.O. Box 1255, Liberal, Kansas
(Address)

SUBSCRIBED AND SWORN to before me this 3rd day of November, 1969

My commission expires 9/19/70

James R. [Signature]
Notary Public.
JAMES R. HARRIS
NOTARY PUBLIC
SEWARD CO. KANSAS

WELL LOG

COMPANY Petroleum, Inc.

SEC. 25 T. 34S R. 33W

FARM Warden NO. 3

LOC. C NW NE

TOTAL DEPTH 6420'

COUNTY Seward, Kansas

COMM. 10-14-69 COMP. 10-29-69

CONTRACTOR Garvey Drilling Company

CASING
8 5/8" @ 1569' w/800sx

ELEVATION

PRODUCTION D & A

FIGURES INDICATE BOTTOM OF FORMATIONS

- 400' Surface Soil & Sand
- 880' Surface Sand & Red Bed
- 1571' Red Bed
- 2312' Shale & Shells
- 2692' Lime & Shale
- 4075' Shale & Lime
- 4257' Lime & Shale
- 4500' Lime
- 4674' Lime & Shale
- 5007' Lime
- 5290' Lime & Shale
- 5415' Lime
- 5583' Lime & Shale
- 6252' Lime
- 6340' Lime & Shale
- 6404' Shale & Lime
- 6420' Lime
- 6420' RTD

RECEIVED
STATE CORPORATION COMMISSION
DEC 24 1969
CONSERVATION DIVISION
Wichita, Kansas

State of Kansas }
County of Barton } SS

I, Charlene Marker of Garvey Drilling Company

upon oath state the above and foregoing is a true and correct copy of the log of the Warden No. 3 well.

Charlene Marker

Subscribed and sworn to before me this 6th day of November 19 69

My Commission Expires: November 5, 1973

Richard A. Boyd
NOTARY PUBLIC