


STATE OF KANSAS
STATE CORPORATION COMMISSION

Form CP-4

WELL PLUGGING RECORD

Give All Information Completely
Make Required Affidavit
Mail or Deliver Report to:
Conservation Division
State Corporation Commission
211 No. Broadway
Wichita, Kansas

NORTH

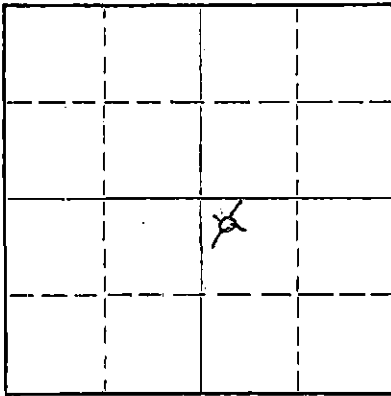

Locate well correctly on above
Section Flat

Seward County. Sec. 31 Twp. 34 Rge. 34 (E) W (W)
Location as "NE/CNW/SW" or footage from lines C- NW- SE
Lease Owner A. J. Curtis & Mahoney
Lease Name Dowdy Well No. 1-31
Office Address Box 1257 Liberal, Kansas
Character of Well (completed as Oil, Gas or Dry Hole) Dry Hole
Date well completed 12/9/1964
Application for plugging filed 3-14 1965
Application for plugging approved 3-18 1965
Plugging commenced 3-25 1965
Plugging completed 3-27 1965
Reason for abandonment of well or producing formation Non Productive

If a producing well is abandoned, date of last production None 19
Was permission obtained from the Conservation Division or its agents before plugging was commenced? Yes

Name of Conservation Agent who supervised plugging of this well Hugh Scott
Producing formation None Depth to top Bottom Total Depth of Well 6752 Feet
Show depth and thickness of all water, oil and gas formations.

OIL, GAS OR WATER RECORDS

CASING RECORD

FORMATION	CONTENT	FROM	TO	SIZE	PUT IN	PULLED OUT
				13 2/8	735	none
				9 5/8	2905	none
				4 1/2	6750	2952

Describe in detail the manner in which the well was plugged, indicating where the mud fluid was placed and the method or methods used in introducing it into the hole. If cement or other plugs were used, state the character of same and depth placed, from feet to feet for each plug set.

Mix 20 sacks cement with pump truck to plug off perforations at 4360. Stop plug at 478 feet. Spot 35 sacks cement at 700 feet with pump truck through 4 1/2" casing. put 15 sacks cement at 45 feet to 0'.

RECEIVED
STATE CORPORATION COMMISSION

APR 6 1965

CONSERVATION DIVISION
Wichita, Kansas

(If additional description is necessary, use BACK of this sheet)

Name of Plugging Contractor Sargent's Casing Pulling Service
Address Box 506 Liberal, Kansas

STATE OF Kansas, COUNTY OF Seward, ss.
(employee of owner) or (owner or operator) of the above-described well, being first duly sworn on oath, says: That I have knowledge of the facts, statements, and matters herein contained and the log of the above-described well as filed and that the same are true and correct. So help me God.

(Signature) A. W. Mahoney
Box 1257 Liberal, Kansas
(Address)

SUBSCRIBED AND SWORN to before me this 5 th day of April, 19 65

My commission expires Jan. 24, 1968

George W. Carmichael
Notary Public.



15-175-10211-0000

DOWDY 1-31'
NW K Se Sec. 31-34-35
Seward County, Kansas

STARTED 11-7-64
4 1/2" Csg. Set 6750'
Stage collar Set 4622'

Wash Old Hole Down
Line
Line
FD

6570 0-~~6250~~ 6570
~~6250~~-6650
6650-6745
6745'

THIS IS A TRUE AND EXACT COPY OF THE FORMATION, TAKEN FROM
THE DAILY DRILLING REPORTS.

T. W. Mahoney
T. W. MAHONEY, PRESIDENT

STATE OF KANSAS
COUNTY OF SEWARD

SWORN TO BEFORE ME THIS 28 DAY OF NOVEMBER, 1964

George W. Carnahan Jr.
NOTARY PUBLIC

MY COMMISSION EXPIRES JANUARY 24, 1968

RECEIVED
STATE CORPORATION COMMISSION
APR 6 1965
CONSERVATION DIVISION
Wichita, Kansas