

JUL 19 1984

STATE OF KANSAS STATE CORPORATION COMMISSION

Give All Information Completely Make Required Affidavit Mail or Deliver Report to Conservation Division State Corporation Comm. 245 North Water Wichita, KS 67202

WELL PLUGGING RECORD CONSERVATION DIVISION Wichita, Kansas


Seward County, Sec. 31 Twp. 34 Rge. 34 X/W Location as "NE/CNW 1/4 SW 1/4" or footage from lines C NW NE Lease Owner PAR Petroleum, Inc. Lease Name Dowdy Well No. 1-A Office Address P.O. Box 280, Liberal, Kansas 67901 Character of Well (Completed as Oil, Gas or Dry Hole) Dry Hole

Date Well completed 7-5-1984 Application for plugging filed 7-10-1984 Application for plugging approved 7-16-1984 Plugging commenced 7-5-1984 Plugging completed 7-5-1984

Reason for abandonment of well or producing formation Dry Hole If a producing well is abandoned, date of last production NA 19

Was permission obtained from the Conservation Division or its agents before plugging was commenced? Yes

Name of Conservation Agent who supervised plugging of this well Ken Beakey Producing formation NA Depth to top Bottom Total Depth of Well Show depth and thickness of all water, oil and gas formations.

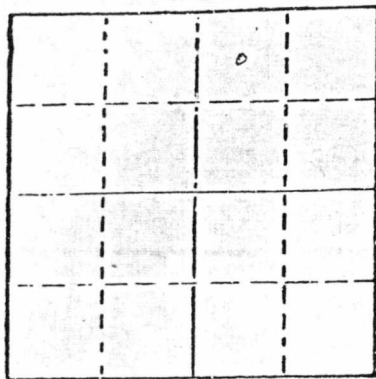

Locate well correctly on above Section Plat

OIL, GAS OR WATER RECORDS

CASING RECORD

Table with 7 columns: FORMATION, CONTENT, FROM, TO, SIZE, PUT IN, PULLED OUT. All cells are empty.

Describe in detail the manner in which the well was plugged, indicating where the mud fluid was placed and the method or methods used in introducing it into the hold. If cement or other plugs were used, state the character of same and depth placed, from feet to feet for each plug set.

- 40 Sks @ 1650'
25 Sks @ 660'
Wooden plug and 10 sks from 0' to 10'
10 sks in rathole
10 sks in mousehole
Cement plug in water well from 40' to 60'

(If additional description is necessary, use BACK of this sheet)

Name of Plugging Contractor J.B. Bohannon Drilling Company

STATE OF Kansas COUNTY OF Seward, ss. Ralph M. Reynolds (employee of owner) or (owner or operator)

of the above-described well, being first duly sworn on oath, says: That I have knowledge of the facts, statements, and matters herein contained and the log of the above-described well as filed and that the same are true and correct. So help me God.

(Signature) Ralph M. Reynolds P.O. Box 280 Liberal, Kansas 67901 (Address)

SUBSCRIBED AND SWORN TO before me this 17th day of July, 1984

Marjorie A. Kennedy Notary Public.

My commission expires January 8, 1988

