


STATE OF KANSAS
STATE CORPORATION COMMISSION

WELL PLUGGING RECORD

Give All Information Completely
Make Required Affidavit
Mail or Deliver Report to
Conservation Division
State Corporation Comm.
245 North Water
Wichita, KS 67202

SEWARD County. Sec. 30 Twp. 34S Rge. 34W E/W
Location as "NE/CNW $\frac{1}{4}$ SW $\frac{1}{4}$ " or footage from lines
C-SW/4 SW/4 660' FS & WL
Lease Owner SOUTHLAND ROYALTY COMPANY
Lease Name SRC-SANDIFER Well No. 1-30
Office Address 2900 LIBERTY TOWER OKC, OK 73102
Character of Well (Completed as Oil, Gas or Dry Hole)
 DRY HOLE

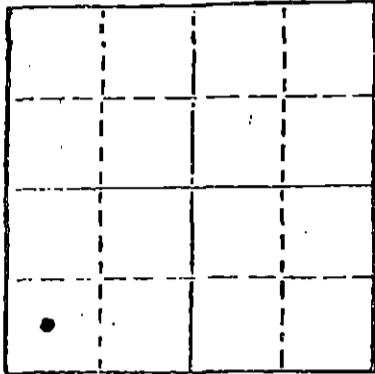

Locate well correctly on above
Section Plat

Date Well completed _____ 19____
Application for plugging filed VERBAL _____ 19____
Application for plugging approved VERBAL _____ 19____
Plugging commenced _____ 12-21 _____ 1983
Plugging completed 12-22 _____ 1983
Reason for abandonment of well or producing formation
DRY HOLE
If a producing well is abandoned, date of last production
_____ 19____

Was permission obtained from the Conservation Division or
its agents before plugging was commenced? YES

Name of Conservation Agent who supervised plugging of this well MR. PAUL LUPHI
Producing formation _____ Depth to top _____ Bottom _____ Total Depth of Well 6800
Show depth and thickness of all water, oil and gas formations.

OIL, GAS OR WATER RECORDS

CASING RECORD

FORMATION	CONTENT	FROM	TO	SIZE	PUT IN	PULLED OUT
				20"	60'	NONE
				8-5/8"	1660'	NONE

Describe in detail the manner in which the well was plugged, indicating where the mud fluid
was placed and the method or methods used in introducing it into the hold. If cement or other
plugs were used, state the character of same and depth placed, from _____ feet to
_____ feet for each plug set. ENTIRE HOLE LOADED WITH 9.0 PPG 60 VIS MUD. THROUGH
DRILL PIPE A 40 SXS CMT PLUG WAS SET FROM 6060-5960', AND A 50 SX CMT PLG WAS SET
FROM 1700'-1600'. A 30 SX CMT PLG WAS SET FROM 640-580', AND A 10 SX CMT PLG WAS SET
FROM 40-10'. CUT OFF WELLHEAD AND WELDED ON STEEL PLATE.

(If additional description is necessary, use BACK of this sheet)

Name of Plugging Contractor SAGE DRILLING COMPANY

STATE OF OKLAHOMA COUNTY OF OKLAHOMA, ss.
TERRENCE R. WILLIE (employee of owner) or (owner or operator)
of the above-described well, being first duly sworn on oath, says: That I have knowledge of
the facts, statements, and matters herein contained and the log of the above-described well
as filed and that the same are true and correct. So help me God.

(Signature) Terrence R. Willie
2900 LIBERTY TOWER, OKC, OK 73102
(Address)

SUBSCRIBED AND SWORN TO before me this 4TH day of JANUARY, 1984

My commission expires AUGUST 11, 1987

Judy C. Burnett
Notary Public.

RECEIVED
STATE CORPORATION COMMISSION

JAN 06 1984

CONSERVATION DIVISION
Wichita, Kansas