

15-175-10175-0000


STATE OF KANSAS
STATE CORPORATION COMMISSION

Form CP-4

Give All Information Completely
Make Required Affidavit
Mail or Deliver Report to:
Conservation Division
State Corporation Commission
212 No. Market
Wichita, Kansas

WELL PLUGGING RECORD

Seward County, Sec. 36 Twp. 34S Rge. 31W (E) (W)
Location as "NE/CNWxSWx" or footage from lines C/NE/NW
Lease Owner Horizon Oil & Gas Co.
Lease Name Adams "A" Well No. 1-36
Office Address P.O. Box #7, Spearman, Texas 79081
Character of Well (completed as Oil, Gas or Dry Hole) Dry Hole
Date well completed November 25 19 66
Application for plugging filed April 10 19 68
Application for plugging approved April 15 19 68
Plugging commenced April 22 19 68
Plugging completed April 22 19 68
Reason for abandonment of well or producing formation Dry Hole

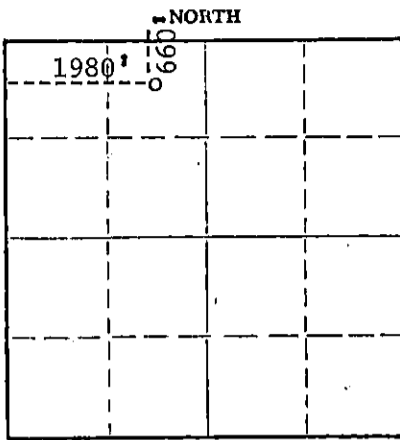

Locate well correctly on above
Section Plat

If a producing well is abandoned, date of last production None 19
Was permission obtained from the Conservation Division or its agents before plugging was commenced? Yes

Name of Conservation Agent who supervised plugging of this well Edgar J. Eves - Box "F" - Sublette, Kans. 67877
Producing formation None - Dry Hole Depth to top - Bottom - Total Depth of Well 6253 Feet
Show depth and thickness of all water, oil and gas formations.

OIL, GAS OR WATER RECORDS

CASING RECORD

FORMATION	CONTENT	FROM	TO	SIZE	PUT IN	PULLED OUT
				8-5/8"	1400	None
St. Louis	Oil & Water	6070	T.D.	4-1/2"	6244	3523'

Describe in detail the manner in which the well was plugged, indicating where the mud fluid was placed and the method or methods used in introducing it into the hole. If cement or other plugs were used, state the character of same and depth placed, from surface feet to 6120' feet for each plug set.

Set 10 sack cement plug from 6,000' to 6,120'
40 sack cement plug from 690' to 570'
10 sack cement plug from 5' to 35'

Welded on cap
Well D & A

(If additional description is necessary, use BACK of this sheet)

Name of Plugging Contractor Daco Lease & Well Service (License No. 138)
Address Borger, Texas

STATE OF Texas, COUNTY OF Hansford, ss.
Everett R. Tracy (employee of owner) or (owner) of the above-described well, being first duly sworn on oath, says: That I have knowledge of the facts, statements, and matters herein contained and the log of the above-described well as filed and that the same are true and correct.

(Signature) *Everett R. Tracy*

P.O. Box #7, Spearman, Texas 79081
(Address)

SUBSCRIBED AND SWORN TO before me this 29th day of April, 1968

Jesse Garies
Notary Public.

My commission expires June 1, 1969

Hansford County, Texas