


STATE OF KANSAS
STATE CORPORATION COMMISSION

Form CP-4

WELL PLUGGING RECORD

Give All Information Completely
Make Required Affidavit
Mail or Deliver Report to:
Conservation Division
State Corporation Commission
212 No. Market
Wichita, Kansas

NORTH

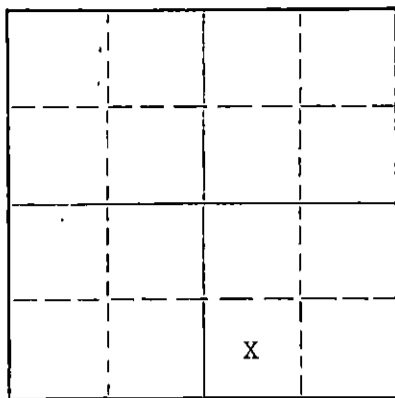

Locate well correctly on above
Section Plat

Seward County, Sec. 34 Twp. 34 Rge. 31 (E) (W)
Location as "NE/CNW/SW" or footage from lines SW-SE
Lease Owner Parlay Oil, Inc.
Lease Name Basore Well No. 1
Office Address Box 488, Spearman, Texas
Character of Well (completed as Oil, Gas or Dry Hole) D & A
Date well completed February 13, 1968
Application for plugging filed February 13, 1968
Application for plugging approved February 13, 1968
Plugging commenced February 13, 1968
Plugging completed February 13, 1968
Reason for abandonment of well or producing formation Dry
If a producing well is abandoned, date of last production 19____
Was permission obtained from the Conservation Division or its agents before plugging was commenced? Yes

Name of Conservation Agent who supervised plugging of this well Edgar Eves, Sublette, Kansas
Producing formation _____ Depth to top _____ Bottom _____ Total Depth of Well 6100 Feet
Show depth and thickness of all water, oil and gas formations.

OIL, GAS OR WATER RECORDS

CASING RECORD

FORMATION	CONTENT	FROM	TO	SIZE	PUT IN	PULLED OUT
		0	1451'	8 5/8"		

Describe in detail the manner in which the well was plugged, indicating where the mud fluid was placed and the method or methods used in introducing it into the hole. If cement or other plugs were used, state the character of same and depth placed, from _____ feet to _____ feet for each plug set.

900' - 800' w/35 sx.
45' - 0' w/15 sx.

RECEIVED
STATE CORPORATION COMMISSION
FEB 27 1968
CONSERVATION DIVISION
Wichita, Kansas


(If additional description is necessary, use BACK of this sheet)
Name of Plugging Contractor Zenith Drilling Corp., Inc.
Address Suite 737 - 300 W. Douglas, Wichita, Kansas

STATE OF Kansas, COUNTY OF Sedgwick, ss.
C. Robert Buford, (employee of owner) or (owner or operator) of the above-described well, being first duly sworn on oath, says: That I have knowledge of the facts, statements, and matters herein contained and the log of the above-described well as filed and that the same are true and correct. So help me God.

(Signature) *C Robert Buford*
Suite 737 - 300 W. Douglas, Wichita, Kansas
(Address)

SUBSCRIBED AND SWORN TO before me this 16 day of February, 1968

My commission expires August 15, 1971.

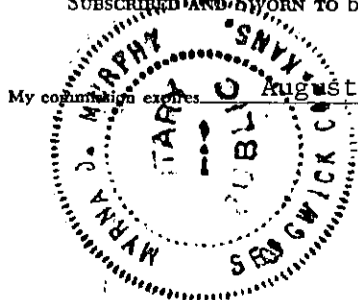

Myrna D. Murphy
Myrna D. Murphy
Notary Public.

