

STATE OF KANSAS  
STATE CORPORATION COMMISSION

Form CP-4

WELL PLUGGING RECORD

Give All Information Completely  
Make Required Affidavit  
Mail or Deliver Report to:  
Conservation Division  
State Corporation Commission  
P. O. Box 17027  
Wichita, Kansas 67217  
NORTH

Seward

County, Sec. 33 Twp. 34 Rge. 31 (E) (W)

Location as "NE/CNWxSWx" or footage from lines. C NW/ NW/4

Lease Owner Ted R. Lofland

Lease Name Jenettie Long Well No. 1

Office Address RFD # 1, Box 85, Liberal, Kansas.

Character of Well (completed as Oil, Gas or Dry Hole) gas

Date well completed 1952 19

Application for plugging filed 19

Application for plugging approved 19

Plugging commenced 2-10 19 73


Plugging completed 2-13 19 73

Reason for abandonment of well or producing formation no pipeline facilities

Owner sued for her lease back.

If a producing well is abandoned, date of last production 19

Was permission obtained from the Conservation Division or its agents before plugging was commenced? yes

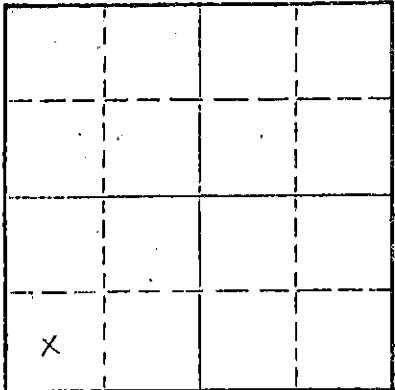

Locate well correctly on above Section Plat

Name of Conservation Agent who supervised plugging of this well Edd Eves, Sublette, Kansas

Producing formation Depth to top Bottom Total Depth of Well 5200 Feet

Show depth and thickness of all water, oil and gas formations.

OIL, GAS OR WATER RECORDS

CASING RECORD

| FORMATION | CONTENT | FROM | TO | SIZE  | PUT IN | PULLED OUT |
|-----------|---------|------|----|-------|--------|------------|
|           |         |      |    | 5 1/2 | 5200   | 2718.10    |
|           |         |      |    | 9 5/8 | 2700   | 413.77     |
|           |         |      |    | 13    | 450    | -0-        |
|           |         |      |    |       |        |            |
|           |         |      |    |       |        |            |
Describe in detail the manner in which the well was plugged, indicating where the mud fluid was placed and the method or methods used in introducing it into the hole. If cement or other plugs were used, state the character of same and depth placed, from feet to feet for each plug set.

Mix and pump 20 sacks cement from 4715 to 4875, spot 60 sacks cement from 300 to 400, run 25 sacks cement from 5 to 25.

RECEIVED  
STATE CORPORATION COMMISSION  
APR 16 1973  
CONSERVATION DIVISION  
Wichita, Kansas

(If additional description is necessary, use BACK of this sheet)  
Name of Plugging Contractor Daco Lease & Well Service  
Address 1700 South Main Borger, Texas, 79007

STATE OF KANSAS, COUNTY OF SEWARD, ss.  
Ted R. Lofland (employee of owner) or (owner or operator) of the above-described well, being first duly sworn on oath, says: That I have knowledge of the facts, statements, and matters herein contained and the log of the above-described well as filed and that the same are true and correct. So help me God.

(Signature) Ted R. Lofland

(Address)

Subscribed and sworn to before me this 26th day of April, 1973



Carol V. Hecox  
Notary Public.

RECEIVED  
STATE CORPORATION COMMISSION

DEC 18 1972

CONSERVATION DIVISION  
Wichita, KansasTHE UNIT DRILLING COMPANY  
BRISTOW, OKLAHOMATED R. LOFLAND, OPERATOR  
F & M LOFLAND JOINT VENTURE NO. 7JNETTIE LONG WELL NO. 1  
center NW/4 NW/4 Section 33-34S-31W  
Seward County, KansasOperation Commenced 6-9 - 52  
Operation Completed 7-29 - 52

## DRILLERS LOG

|             |                     |
|-------------|---------------------|
| 0 - 400     | Sand & Shale        |
| 400 - 575   | Shale               |
| 575 - 640   | Sand & shale        |
| 640 - 885   | Red bed             |
| 885 - 945   | Anhydrite           |
| 945 - 1060  | Shale & shale       |
| 1060 - 1300 | Red bed & shale     |
| 1300 - 1485 | Shale & shells      |
| 1485 - 1555 | Shale               |
| 1555 - 1617 | Chert & gyp         |
| 1617 - 1720 | Shale & lime        |
| 1720 - 1730 | Lime                |
| 1730 - 1809 | Shale & lime        |
| 1809 - 1986 | Shale               |
| 1986 - 2031 | Shale and Anhydrite |
| 2031 - 2116 | Shale               |
| 2116 - 2175 | Lime                |
| 2175 - 2214 | Lime and anhydrite  |
| 2214 - 2292 | Lime & shale        |
| 2292 - 2345 | Lime                |
| 2345 - 2365 | Anhydrite           |
| 2365 - 2407 | Lime                |
| 2407 - 2454 | Anhydrite           |
| 2454 - 2512 | Lime                |
| 2512 - 2555 | Anhydrite & lime    |
| 2555 - 2585 | Anhydrite           |
| 2585 - 2865 | Lime                |
| 2862 - 2986 | Lime & shale        |
| 2986 - 3611 | Lime                |
| 3611 - 3705 | Lime & shale        |
| 3705 - 3765 | Lime                |
| 3765 - 3820 | Lime & shale        |
| 3820 - 3895 | Lime                |
| 3895 - 3980 | Shale               |
| 3980 - 4385 | Shale & Lime        |
| 4385 - 4923 | Lime                |
| 4923 - 4949 | Lime & shale        |
| 4949 - 4963 | Lime                |
| 4963 - 4986 | Lime & chert        |
| 4986 - 5065 | Lime                |

|             |              |
|-------------|--------------|
| 5065 - 5120 | Sand         |
| 5120 - 5135 | Shale & lime |
| 5135 - 5245 | Lime         |
| 5245 - 5537 | Lime & shale |
| 5537 - 5565 | Lime         |
| 5565 - 5944 | Lime & shale |
| 5944 - 6005 | Lime & sand  |
| 6005 - 6060 | Sand & shale |
| 6060 - 6231 | Lime & shale |
| 6231 - 6298 | Lime         |
| 6298 - 6322 | Sand & lime  |
| 6322 - 6505 | Lime         |
| 6505 - 6545 | Lime & chert |
| 6545 - 6723 | Lime         |
| 6723 - 6738 | Lime & shale |
| 6738 - 6800 | Lime         |
| 6800        | Total depth  |

RECEIVED  
STATE CORPORATION COMMISSION

DEC 18 1972

CONSERVATION DIVISION  
Wichita, Kansas

CASING RECORD

- 6-10-52 Ran 693.81' of 13-3/8" O.D. casing overall, 675' from top of Rotary Table. Cemented with 600 sacks. Cement circulated.
- 6-19-52 Ran 2676.16' of 9 5/8" O.D. casing overall, 2641.16' from top of Rotary Table. Cemented with 600 sacks common cement.
- 6-29-52 Ran 6154.35' of 5 1/4" O.D. casing overall, 6150' from top of Rotary Bushing. Cemented with 450 sacks.

Note: All measurements from Kelly Bushing approximately 12 feet above ground level.