


STATE OF KANSAS
STATE CORPORATION COMMISSION

Form CP-4

Give All Information Completely
Make Required Affidavit
Mail or Deliver Report to:
Conservation Division
State Corporation Commission
212 No. Market
Wichita, Kansas 67202

WELL PLUGGING RECORD

NORTH

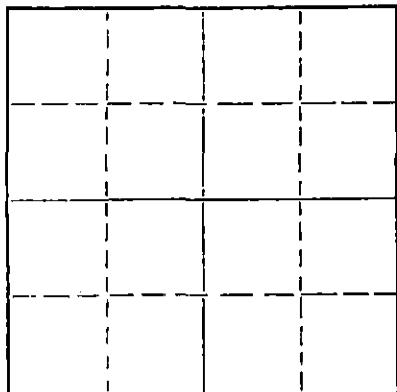

Locate well correctly on above
Section Plat

Seward County, Sec. 30 Twp. 34 Rge. (E) 31 (W)
Location as "NE/CNW/SW" or footage from lines C NW SE
Lease Owner Lehen Drilling, Inc.
Lease Name Davies Well No. 1
Office Address P.O. Box 486 Great Bend, Kansas
Character of Well (completed as Oil, Gas or Dry Hole) dry hole
Date well completed January 8 1971
Application for plugging filed January 8 1971
Application for plugging approved January 8 1971
Plugging commenced January 8 1971
Plugging completed January 8 1971
Reason for abandonment of well or producing formation dry hole

If a producing well is abandoned, date of last production 19____
Was permission obtained from the Conservation Division or its agents before plugging was commenced? yes

Name of Conservation Agent who supervised plugging of this well Edgar Eves
Producing formation _____ Depth to top _____ Bottom _____ Total Depth of Well 6485 Feet
Show depth and thickness of all water, oil and gas formations.

OIL, GAS OR WATER RECORDS

CASING RECORD

FORMATION	CONTENT	FROM	TO	SIZE	PUT IN	PULLED OUT
				8 5/8"	1502'	none

Describe in detail the manner in which the well was plugged, indicating where the mud fluid was placed and the method or methods used in introducing it into the hole. If cement or other plugs were used, state the character of same and depth placed, from _____ feet to _____ feet for each plug set.

Run 1000' open pipe in hole, cemented w/35 sxs. Common @ 1000'
and 15 sxs. Common @ 45'

RECEIVED
STATE CORPORATION COMMISSION
FEB 16 1971
CONSERVATION DIVISION
Wichita, Kansas


(If additional description is necessary, use BACK of this sheet)

Name of Plugging Contractor Lehen Drilling, Inc.
Address P.O. Box 486 Great Bend, Kansas 67530

STATE OF Kansas, COUNTY OF Barton, ss.
James R. Rodgers (employee of owner) or (owner or operator) of the above-described well, being first duly sworn on oath, says: That I have knowledge of the facts, statements, and matters herein contained and the log of the above-described well as filed and that the same are true and correct. So help me God.

(Signature) James R. Rodgers
P.O. Box 486 Great Bend, Kansas
(Address)

Subscribed and sworn to before me this 11th day of February, 1971

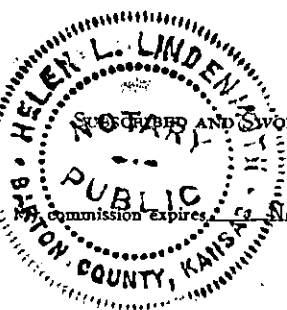

Helen L. Lindenmuth
Notary Public.

WELL LOG

Company Leben Drilling, Inc.
Contractor Leben Drilling, Inc.
Farm Davies #1
Total Depth 6485'RTD
Commenced 12-16-70
Completed 1-8-71

Sec. 30 T. 34 R. 31
Loc. C NW SE
County Seward

Casing 8 5/8" New 24# Csg. set @ 1502'
w/600 sxs. 50/50 Poz. 6% Gel 2% CC
Production 200 sxs. Common 2% G.C.

D & A

Figures Indicate Bottom of Formations

318	Surface Soil & Sand
975	Sand, Red Bed, & Shale
1000	Shale & Red Bed
1150	Sand
1490	Shale & Red Bed
1502	Anhydrite
1620	Shale
2150	Red Bed, Shale
2456	Shale & Anhydrite
2590	Shale & Lime
2760	Anhydrite, Dolomite
6485	Lime & Shale
6485	RTD

RECEIVED
STATE CORPORATION COMMISSION
FEB 16 1971
CONSERVATION DIVISION
Wichita, Kansas

State of Kansas
County of Barton } SS

I, James R. Rodgers of Leben Drilling, Inc., upon oath state that the above and foregoing is a true and correct copy of the log of the Davies #1 Well.

James R. Rodgers

Subscribed and sworn to before me this 11th day of February, 1970

My Commission Expires:
November 13, 1973

Helen L. Lindenmuth

