

STATE OF KANSAS
STATE CORPORATION COMMISSION

Give All Information Completely
Make Required Affidavit
Mail or Deliver Report to:
Conservation Division
State Corporation Commission
800 Bitting Building
Wichita, Kansas

96
WELL PLUGGING RECORD

Meade County, Sec. 32 Twp. 33 Rge. (E) 29 (W)

Location as "NE/CNW/SW" or footage from lines NW SE

Lease Owner Colorado Oil and Gas Corporation

Lease Name Adams Well No. 1-32

Office Address P. O. Box 999, Liberal, Kansas

Character of Well (completed as Oil, Gas or Dry Hole) Oil

Date well completed 12-26 1956

Application for plugging filed 5-9 1961

Application for plugging approved 5-17 1961


Plugging commenced 6-10 1961

Plugging completed 6-13 1961

Reason for abandonment of well or producing formation Non Commercial

If a producing well is abandoned, date of last production 5-12 1961

Was permission obtained from the Conservation Division or its agents before plugging was commenced? Yes

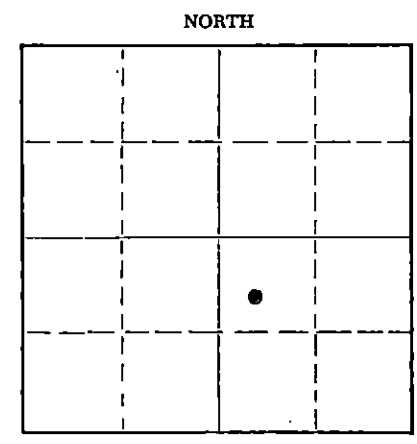

Locate well correctly on above Section Plat

Name of Conservation Agent who supervised plugging of this well W. L. Lackamp Jr.

Producing formation Morrow Depth to top Bottom Total Depth of Well 6040 Feet

Show depth and thickness of all water, oil and gas formations. PETD 5890

OIL, GAS OR WATER RECORDS

CASING RECORD

FORMATION	CONTENT	FROM	TO	SIZE	PUT IN	PULLED OUT
Morrow	Oil	5821	5834	8 5/8	1521	None
		5852	5858	5 1/2	5924	

Describe in detail the manner in which the well was plugged, indicating where the mud fluid was placed and the method or methods used in introducing it into the hole. If cement or other plugs were used, state the character of same and depth placed, from feet to feet for each plug set.

Filled hole with sand to 5725. Ran 5 sack cement plug to 5709. Filled hole with heavy mud to 750'. Set wooden plug with 10' rock bridge and 20 sacks cement to 630'. Heavy mud to 40' with 10' rock bridge and 10 sacks cement to bottom of cellar, 5' below ground level.

RECEIVED
STATE CORPORATION COMMISSION
JUN 14 1961
Le-19-161
CONSERVATION DIVISION
Wichita, Kansas

(If additional description is necessary, use BACK of this sheet)
Name of Plugging Contractor Knight Casing Pulling Co.
Address Chase, Kansas

STATE OF Kansas, COUNTY OF Seward, ss.

(employee of owner) or (owner or operator) of the above-described well, being first duly sworn on oath, says: That I have knowledge of the facts, statements, and matters herein contained and the log of the above-described well as filed and that the same are true and correct. So help me God.

(Signature) [Signature] (Address)

SUBSCRIBED AND SWORN to before me this 16 day of June, 1961

My commission expires 11-1-61 William B. Claunch Notary Public.



ADAMS #1Well Record

Location: C/ NW/ SE/ Sec. 32-33S-29W
Meade County, Kansas

Commenced: Nov. 13, 1956
Completed: Dec. 13, 1956
(rotary)

Operator: Colorado Oil & Gas Corp.
P. O. Box 999
Liberal, Kansas

Contractor: Graham-Michaelis Drilling Co.
211 North Broadway
Wichita, Kansas

Casing Record: 8-5/8" @ 1,520' w/900 sacks cement
5-1/2" @ 5,925' w/100 sacks cement

RECEIVED
STATE CORPORATION COMMISSION

MAY 10 1961

CONSERVATION DIVISION
WICHITA

LOG

Shale, Clay & Sand	612
Shale & Lime	1324
Shale & Anhydrite	1541
Shale & Lime	2617
Lime	3139
Lime & Shale	4001
Lime	4079
Shale	4248
Shale & Lime	4615
Lime	5083
Lime & Shale	5157
Lime	5273
Lime & Chert.	5397
Lime & Shale	5410
Lime	5515
Lime & Shale	5788
Sand, Shale & Lime	5828
Shale & Shale	5886
Lime & Shale	5994
Lime	6050, RTD.

STATE OF KANDAS)
) ss.
COUNTY OF SEDGWICK)

The undersigned, GRAHAM-MICHAELIS DRILLING COMPANY, hereby certifies that the above log is a true and correct log of the formations encountered in drilling the above well as reflected by the Daily Drilling Report.

GRAHAM-MICHAELIS DRILLING COMPANY

Subscribed and sworn to before me
this 31st day of December, 1956.

/s/ Flo Duncan

My commission expires: June 23, 1958