


STATE OF KANSAS
STATE CORPORATION COMMISSION

WELL PLUGGING RECORD

API #15-119-20564

Give All Information Completely
Make Required Affidavit
Mail or Deliver Report to
Conservation Division
State Corporation Comm.
245 North Water
Wichita, KS 67202

Meade County, Sec. 1 Twp. 34S Rge. 26 E/W
Location as "NE/CNW 1/4 SW 1/4" or footage from lines C/NW NW SE
of Section -34S-26W.
Lease Owner Gulf Oil Corporation
Lease Name Theis "C" Well No. 2-1
Office Address P.O. Box 12116, Oklahoma City, OK 73157
Character of Well (Completed as Oil, Gas or Dry Hole) DRY

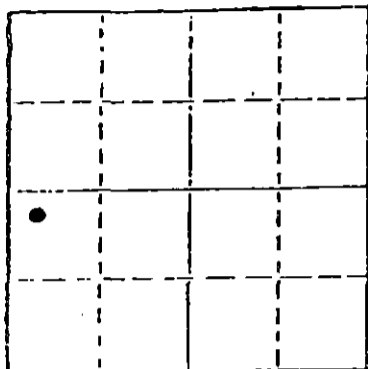

Locate well correctly on above
Section Plat

Date Well completed June 19, 1982
Application for plugging filed -- 19
Application for plugging approved -- 19
Plugging commenced June 19, 1982
Plugging completed June 21, 1982
Reason for abandonment of well or producing formation: no
production found; well completed "dry".
If a producing well is abandoned, date of last production
----- 19

Was permission obtained from the Conservation Division or
its agents before plugging was commenced? YES

Name of Conservation Agent who supervised plugging of this well Paul Leghi @ Minniola, KS *
Producing formation none - dry Depth to top Bottom Total Depth of Well 6000'
Show depth and thickness of all water, oil and gas formations.

* (316)885-4838

OIL, GAS OR WATER RECORDS

CASING RECORD

FORMATION	CONTENT	FROM	TO	SIZE	PUT IN	PULLED OUT
				8-5/8"	1304	-0-

Describe in detail the manner in which the well was plugged, indicating where the mud fluid
was placed and the method or methods used in introducing it into the hold. If cement or other
plugs were used, state the character of same and depth placed, from _____ feet to
_____ feet for each plug set.

- Plug at 900' with 60 sacks 50:50:2 pozmix
- Plug at 300' with 50 sacks cement
- Plug at 40' with 20 sacks cement
- Rat & Mouse Holes cmtd with 10 sacks each

STATE CORPORATION COMMISSION
RECEIVED
JUL 15 1982
CONSERVATION DIVISION
Wichita, Kansas

(If additional description is necessary, use BACK of this sheet)

Name of Plugging Contractor Rains & Williamson Oil Company, Inc.

STATE OF OKLAHOMA COUNTY OF OKLAHOMA, ss.
Dorretta Moore (employee of owner) _____
of the above-described well, being first duly sworn on oath, says: That I have knowledge of
the facts, statements, and matters herein contained and the log of the above-described well
as filed and that the same are true and correct. So help me God.

(Signature) Dorretta Moore
P.O. Box 12116, Oklahoma City, OK 73157
(Address)

SUBSCRIBED AND SWORN TO before me this 14th day of July 1982.

My commission expires 9-15-85

STATE CORPORATION COMMISSION
RECEIVED
JUL 15 1982
CONSERVATION DIVISION
Wichita, Kansas

