

STATE OF KANSAS  
STATE CORPORATION COMMISSION


Give All Information Completely  
Make Required Affidavit  
Mail or Deliver Report to:  
Conservation Division  
State Corporation Commission  
211 No. Broadway  
Wichita, Kansas

WELL PLUGGING RECORD

CLARK County. Sec. 33 Twp. 34S Rge. 25 (X) W (W)

Location as "NE/CNW/SW" or footage from lines C-NW/4  
Lease Owner GENERAL AMERICAN OIL COMPANY OF TEXAS  
Lease Name WALKER "UNIT" Well No. 1  
Office Address MEADOWS BUILDING, DALLAS 6, TEXAS  
Character of Well (completed as Oil, Gas or Dry Hole) DRY ROTARY  
Date well completed APRIL 2, 1959  
Application for plugging filed APRIL 2, 1959  
Application for plugging approved APRIL 2, 1959  
Plugging commenced APRIL 2, 1959  
Plugging completed APRIL 2, 1959  
Reason for abandonment of well or producing formation No productible zone

NORTH

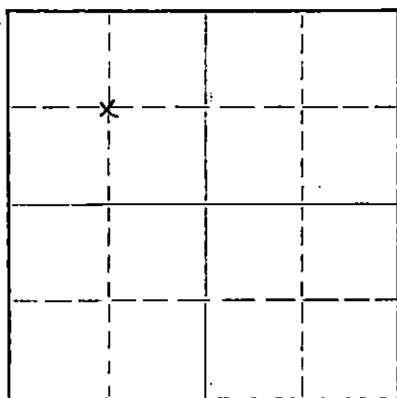

Locate well correctly on above Section Plat

If a producing well is abandoned, date of last production 19  
Was permission obtained from the Conservation Division or its agents before plugging was commenced? Yes

Name of Conservation Agent who supervised plugging of this well MERLE A. RIVES  
Producing formation Depth to top Bottom Total Depth of Well 6000 Feet  
Show depth and thickness of all water, oil and gas formations.

OIL, GAS OR WATER RECORDS

CASING RECORD

FORMATION	CONTENT	FROM	TO	SIZE	PUT IN	PULLED OUT
				8 5/8"	1302'	

Describe in detail the manner in which the well was plugged, indicating where the mud fluid was placed and the method or methods used in introducing it into the hole. If cement or other plugs were used, state the character of same and depth placed, from feet to feet for each plug set.

Gunned up pits, started laying down drill pipe filling hole up to 1275', pushed 1/3 sx. hulls and plug to 1275' capping w/20 sx. cement through drill pipe.

Filled hole up to 41' GL, pushed 1/3 sx. hulls, plug to 41' capping with 10 sx. cement through drill pipe up to base of well cellar.

Job complete @ 4:30 PM, 4-2-59

(If additional description is necessary, use BACK of this sheet)

Name of Plugging Contractor GARVEY DRILLING COMPANY  
Address ROUTE #2, GREAT BEND, KANSAS

STATE OF KANSAS COUNTY OF BARTON ss.  
VERNE A. MORRIS (employee of owner) or (owner or operator) of the above-described

well, being first duly sworn on oath, says: That I have knowledge of the facts, statements, and matters herein contained and the log of the above-described well as filed and that the same are true and correct. So help me God.

(Signature) Verne A. Morris

ROUTE #2, GREAT BEND, KANSAS (Address)

SUBSCRIBED AND SWORN TO before me this 3rd day of April, 1959

Notary Public.

My commission expires November 12, 1962

RECEIVED  
STATE CORPORATION COMMISSION

PLUGGING  
FILE SEC. 33 T. 34 R. 25w  
BOOK PAGE 27 LINE 38

APR 4 1959  
CONSERVATION DIVISION  
Wichita, Kansas

15-025-10082-0000

WELL LOG BUREAU—KANSAS GEOLOGICAL SOCIETY  
503 East Murdock, Wichita, Kansas


**COPY**

Company- GENERAL AMERICAN OIL COMPANY OF TEXAS  
Farm- Walker, No. 1

SEC. 33 T. 34 R. 25W  
C NW/4

Total Depth. 6003'  
Comm. 3-11-59 Comp. 4-2-59  
Shot or Treated.  
Contractor. Garvey Drilling Co.  
Issued. 5-30-59

County Clark KANSAS

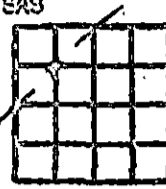

CASING:  
3 5/8" @ 1302' w/750 sq,

Elevation. 2027' GL

Production. Dry

Figures indicate Bottom of Formations.

surface soil & sand	40
sand & red bed	300
red bed & shale	650
shale & gyp	870
shale & sand & gyp	1230
red bed	1259
anhydrite	1279
red bed & shale	1303
shale & shells	2100
lime & shale	3220
shale & chalky lime	3400
lime & shale	4685
chalky lime & shale	4760
lime & shale	5110
lime	5175
lime & shale	5285
lime	5330
lime & shale	6000
lime & shale	6003
Total Depth	

TOPS: SCOUR	
Lansing	4490
Morrow	5672
Miss. Chester	5730

**RECEIVED**  
STATE CORPORATION COMMISSION  
MAR 17 1966  
CONSERVATION DIVISION  
Wichita, Kansas