


STATE OF KANSAS  
STATE CORPORATION COMMISSION

WELL PLUGGING RECORD

Give All Information Completely  
Make Required Affidavit  
Mail or Deliver Report to  
Conservation Division  
State Corporation Comm.  
245 North Water  
Wichita, KS 67202

Clark County. Sec. 30 Twp. 34 Rge. 25 <sup>X</sup>/<sub>W</sub>  
Location as "NE/CNW $\frac{1}{4}$ SW $\frac{1}{4}$ " or footage from lines

C E/2 of W/2 of SW/4  
Lease Owner Calvin Exploration Inc.  
Lease Name Harrington Well No. 1-30  
Office Address 1125 17th St., Suite 2000, Denver, Co. 80202  
Character of Well (Completed as Oil, Gas or Dry Hole)

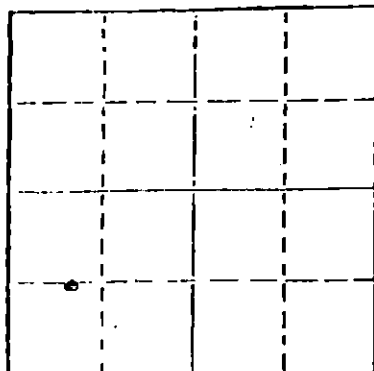

Locate well correctly on above  
Section Plat

Gas & Oil  
Date Well completed 10/25/79 19  
Application for plugging filed 12-1-82 19  
Application for plugging approved 12-3-82 19  
Plugging commenced 12-21-82 19  
Plugging completed 1-3-83 19  
Reason for abandonment of well or producing formation  
Non Commercial Value  
If a producing well is abandoned, date of last production  
2/6/82 19

Was permission obtained from the Conservation Division or  
its agents before plugging was commenced? yes

Name of Conservation Agent who supervised plugging of this well Mr. Luthi  
Producing formation Morrow Depth to top 5802' Bottom 5816' Total Depth of Well 5960'  
Show depth and thickness of all water, oil and gas formations.

OIL, GAS OR WATER RECORDS

CASING RECORD

FORMATION	CONTENT	FROM	TO	SIZE	PUT IN	PULLED OUT
Surface				8 5/8"	1160	0'
Production				4 1/2"	5914'	4540'

Describe in detail the manner in which the well was plugged, indicating where the mud fluid  
was placed and the method or methods used in introducing it into the hold. If cement or other  
plugs were used, state the character of same and depth placed, from \_\_\_\_\_ feet to  
\_\_\_\_\_ feet for each plug set.

Pumped 2 sks. hulls & 25 sks. cement to 5440' - Pressured to 750 lbs.  
Layed down 4 1/2" to 1800' and pumped 40 sks. cement 1800' to 1650'  
Layed down 4 1/2" to 1200' and pumped 35 sks. cement 1200' to 1100'  
Layed down rest of 4 1/2"  
Put bridge and 10 sks. cement 40' to 0'  
Cut off 8 5/8", 3' below ground level

(If additional description is necessary, use BACK of this sheet)

Name of Plugging Contractor Midwest Casing Pulling Service

STATE OF Kansas COUNTY OF Haskell, ss.  
I, Edgar J. Eves (~~employee of owner~~) or (owner or operator)

of the above-described well, being first duly sworn on oath, says: That I have knowledge of  
the facts, statements, and matters herein contained and the log of the above-described well  
as filed and that the same are true and correct. So help me God.

(Signature)

Edgar J. Eves

Box F, Sublette, Ks. 67877

(Address)

SUBSCRIBED AND SWORN TO before me this 10th day of Jan., 1983

Sondra L. Eves

Notary Public.

My commission expires 12-6-84



RECEIVED  
STATE CORPORATION COMMISSION

JAN 19 1983

CONSERVATION DIVISION  
Wichita Kansas