


STATE OF KANSAS
STATE CORPORATION COMMISSION

Give All Information Completely
Make Required Affidavit
Mail or Deliver Report to:
Conservation Division
State Corporation Commission
800 Bittig Building
Wichita, Kansas

WELL PLUGGING RECORD

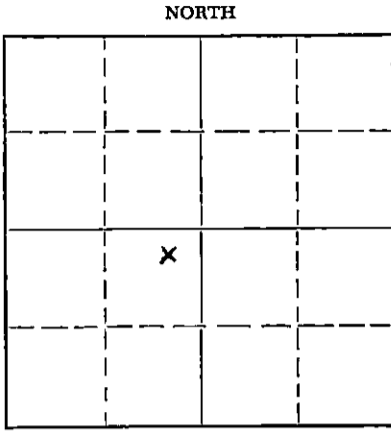

Locate well correctly on above
Section Plat

Clark County, Sec. 30 Twp. 34 Rge. (E) 25 (W)
Location as "NE/CNW/SW" or footage from lines 100' W of NE/4 NE/4 SW/4
Lease Owner Delhi Oil Corporation
Lease Name T. E. & E. H. Davis Well No. 2
Office Address 823 Corrigan Tower, Bldg., Dallas, Texas
Character of Well (completed as Oil, Gas or Dry Hole) Dry hole
Date well completed October 11 1953
Application for plugging filed October 12 1953
Application for plugging approved October 12 1953
Plugging commenced October 12 1953
Plugging completed October 12 19 53
Reason for abandonment of well or producing formation No commercial shows of oil or gas
If a producing well is abandoned, date of last production _____ 19____
Was permission obtained from the Conservation Division or its agents before plugging was commenced? Yes

Name of Conservation Agent who supervised plugging of this well M. A. Rives, Pratt, Kansas
Producing formation None Depth to top _____ Bottom _____ Total Depth of Well 6240 Feet
Show depth and thickness of all water, oil and gas formations.

OIL, GAS OR WATER RECORDS

CASING RECORD

| FORMATION | CONTENT | FROM | TO | SIZE | PUT IN | PULLED OUT |
|-----------|---------|------|----|---------|--------|------------|
| | | | | 18" | 60' | 0 |
| | | | | 10 3/4" | 563' | 0 |
| | | | | 7 5/8" | 2654' | 393' |
| | | | | | | |
| | | | | | | |
| | | | | | | |
| | | | | | | |

Describe in detail the manner in which the well was plugged, indicating where the mud fluid was placed and the method or methods used in introducing it into the hole. If cement or other plugs were used, state the character of same and depth placed, from _____ feet to _____ feet for each plug set.

bridged and 25 sack cement plug set from 565' to 675'
Bridged and plugged with 15 sacks cement from 0' to 40'
10 3/4" casing cut off 3' below surface
Cellar filled and levelled.

RECEIVED
STATE CORPORATION COMMISSION
OCT 17 1953
CONSERVATION DIVISION
Wichita, Kansas

(If additional description is necessary, use BACK of this sheet)
Name of Plugging Contractor San Juan Drilling Company - Rotary
Address Farmington, New Mexico

STATE OF Texas, COUNTY OF Dallas, ss.
R. G. Carlin (employee of owner) or (owner/operator) of the above-described well, being first duly sworn on oath, says: That I have knowledge of the facts, statements, and matters herein contained and the log of the above-described well as filed and that the same are true and correct. So help me God.

(Signature) R. G. Carlin
823 Corrigan Tower, Dallas, Texas
(Address)

SUBSCRIBED AND SWORN to before me this October day of 19 53
JEAN C. JONES
Notary Public, Dallas County, Texas

My commission expires June 1, 1955 My Commission Expires June 1, 1955 Notary Public.

PLUGGING
FILE SEC 30 T34 R25W
BOOK PAGE 135 LINE 28

T. E. & E. H. Davis #2
 Sec. 13-34N-25W
 Clark County, Kansas

Drilling Log

| | |
|-------------|--------------------|
| 0 - 1641 | Red beds & sand |
| 1641 - 2425 | Sand & shale |
| 2425 - 2483 | Lime & sand |
| 2483 - 2774 | Sandy lime & shale |
| 2774 - 2797 | Lime |
| 2797 - 3034 | Lime & shale |
| 3034 - 3095 | Shale |
| 3095 - 3753 | Lime & shale |
| 3753 - 4410 | Shale |
| 4410 - 4430 | Lime |
| 4430 - 6240 | Lime & shale |

| <u>Geological Formation</u> | <u>Top</u> |
|-----------------------------|------------|
| Wellington | 1630 |
| Wellington Salt | 1920 |
| Hollanberg | 2330 |
| Herrington | 2410 |
| Winifield | 2500 |
| Towanda | 2575 |
| Ft. Riley | 2630 |
| Florance | 2700 |
| Neva | 3230 |
| Heebnar Shale | 4360 |
| Lansing | 4560 |
| Morrow Shale | 5735 |
| Chester | 5788 |
| St. Genevieve | 6192 |

RECEIVED
 STATE CORPORATION COMMISSION

OCT 17 1953

CONSERVATION DIVISION
 Wichita, Kansas

PLUGGING
 FILE SEC 20 T 24 R 25W
 BOOK PAGE 125 LINE 28