

STATE OF KANSAS
STATE CORPORATION COMMISSION


Give All Information Completely
Make Required Affidavit
Mail or Deliver Report to:
Conservation Division
State Corporation Commission
800 Bittling Building
Wichita, Kansas

WELL PLUGGING RECORD

Clark County, Sec. 30 Twp. 34 Rge. 25 (E) (W)

Location as "NE/CNW 1/4 SW 1/4" or footage from lines NE NE SW
Lease Owner Delhi Oil Corporation
Lease Name T. E. and E. H. Davis Well No. 1
Office Address Corrigan Tower, Dallas, Texas
Character of Well (completed as Oil, Gas or Dry Hole) Dry hole
Date well completed August 22 19 53
Application for plugging filed Verbal approval from M. A. Rives 19
Application for plugging approved August 28 19 53
Plugging commenced August 28 19 53
Plugging completed August 28 19 53
Reason for abandonment of well or producing formation Hole cratered

NORTH

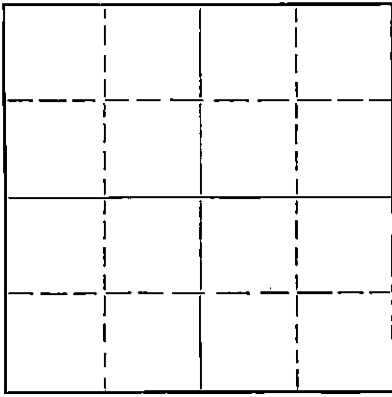

Locate well correctly on above
Section Plat

If a producing well is abandoned, date of last production 19
Was permission obtained from the Conservation Division or its agents before plugging was commenced? Yes

Name of Conservation Agent who supervised plugging of this well M. A. Rives, Pratt, Kansas
Producing formation None Depth to top Bottom Total Depth of Well 499 Feet
Show depth and thickness of all water, oil and gas formations.

OIL, GAS OR WATER RECORDS

CASING RECORD


Formation	Content	From	To	Size	Put In	Pulled Out
Sand	Water	40	46	None		

Describe in detail the manner in which the well was plugged, indicating where the mud fluid was placed and the method or methods used in introducing it into the hole. If cement or other plugs were used, state the character of same and depth placed, from feet to feet for each plug set.

Hit 6' water sand at 40' while drilling 12 1/2" hole; red beds and sand from 65' to 430'.
Lost circulation completely from 430' to 499'. Water sand at 40' washed out and down
to 430' - 499' causing surface to crater and hole was lost. Crater back-filled with
surface sand and clay

Well Log

0 - 499' Sand and red beds

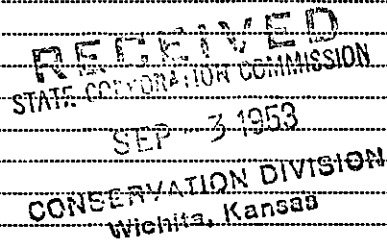

(If additional description is necessary, use BACK of this sheet)

Name of Plugging Contractor San Juan Drilling Company
Address Farmington, New Mexico

STATE OF Texas, COUNTY OF Dallas, SS.
R. G. Carlin (employee of owner) or (owner or operator) of the above-described well,

being first duly sworn on oath, says: That I have knowledge of the facts, statements, and matters herein contained and the log of the above-described well as filed and that the same are true and correct. So help me God.

(Signature) R. G. Carlin

Corrigan Tower, Dallas, Texas (Address)

SUBSCRIBED AND SWORN TO before me this 2nd day of September, 19 53

June 1, 1955

Alta C. Barrow Notary Public.

My commission expires

23-8390-s 6-51-20M

Notary Public, Dallas County, Texas
My Commission Expires June 1, 1955

